

**SURVEY &
REMONUMENTATION**

APR 28 1995

C0158354 LIBER:06543 PAGE:376 08:35A 01/05/1995
CARMELLA SABAUGH-MACOMB COUNTY, MI REG/DEEDS

COMMISSION

**LAND CORNER RECORDATION CERTIFICATE
Filing Requirement of Act 74, Mich. P.A. 1970**

For corners in

<u>MACOMB</u> (County)	Located In: CLINTON	Corner Code # G-11
1. Public Land Survey	T <u>2N</u> R <u>13E</u>	<u>G-11</u>
	T _____ R _____	_____
	T _____ R _____	_____
	T _____ R _____	_____
2. Property Controlling in Section	S _____ T _____ R _____	_____
	S _____ T _____ R _____	_____
3. Miscellaneous Property in Sec.	S _____ T _____ R _____	_____
	S _____ T _____ R _____	_____
4. Lot No. _____, Recorded Plat _____		
5. Private Claims _____		

Register of Deeds Stamp & File Number

I, STEVEN E. DUNN, in a field survey on _____, 19 94, do hereby certify that under requirements of P.A. 74, Michigan P.A. of 1970, the corner points mentioned in lines 1 and 2 above were in conformance with regulations and rules therefore as required in the current manual of survey instructions of the United States Department of the Interior, Bureau of Land Management or by a decree of a Court of Law and /or that the corner points mentioned in lines 3, 4 and 5 above were in conformance with the rules of the Michigan Board of Land Surveyors or by a Decree of a Court of Law; established, re-established, monumented, re-monumented, recovered, found as expressed below:

NOTE: Not more than 4 corners, all in the same town and range, may be recorded on this certificate.

A	B	C	D	E	F	G	H	I	J	K	L	M
2	8	5	4	3	2	1						
3												
4	7	8	9	10	11	12						
6												
6	18	17	16	15	14	13						
7												
8	19	20	21	22	23	24						
9												
10	30	29	28	27	26	25						
11												
12	31	32	33	34	35	36						
13												

A. Description of original monument and accessories and/or subsequent restoration:
GLO POST - NO EVIDENCE OF ORIGINAL CORNER FOUND
GLO ORIGINAL SURVEY PERFORMED BY PRESTON 2-18-1818

<u>L.C.R.C.</u>	<u>NAME AND NUMBER</u>	<u>DESCRIPTION</u>	<u>DATE</u>
L. 2616 P. 56	GEORGE J. AVENDT, JR. #16034	FOUND "+" IN PAVEMENT	SEPTEMBER 10, 1975

<u>CERTIFICATE OF SURVEY</u>	<u>NAME AND NUMBER</u>	<u>DATE</u>
L. 2808 P. 750	GEORGE J. AVENDT, JR. #16034	MARCH 22, 1977

ACCEPTED BY THE MACOMB COUNTY SURVEY PEER GROUP AS THE OFFICIAL CORNER UNDER MICHIGAN PUBLIC ACT 345 OF 1990 AT A MEETING HELD ON 12-13-94
William E. Soderberg
WILLIAM E. SODERBERG, P.S., CHAIRMAN


B. Description of corner evidence found and/or method applied in restoring or reestablishing corner:

G-11 SECTION CORNER

FOUND 1/2" IRON ROD IN MONUMENT BOX IN CONCRETE PAVEMENT
VERIFIED LOCATION BY COMPARING FOUND WITNESSES OF CERTIFICATE OF SURVEY AS LISTED BELOW
DISTANCE FROM F-11 TO G-11 AS SHOWN ON "GRATIOT CITY" SUBDIVISION AS RECORDED IN LIBER 7 OF PLATS ON PAGE 39 (M.C.R.).

FOUND WITNESSES
L. 2808 P. 750 SW 48.50' SET 2-HEADED NAIL IN CAP IN LIGHT POLE

FIELD MEASUREMENTS AND RECORDED DISTANCES
G-11 TO F-11 2709.11' (M.) 2705.70' (R.) GRATIOT CITY SUBDIVISION 39.96 (GLO) 2637.36'
G-11 TO G-13 5388.94' (M.) 40.00 (GLO) 2640.00'

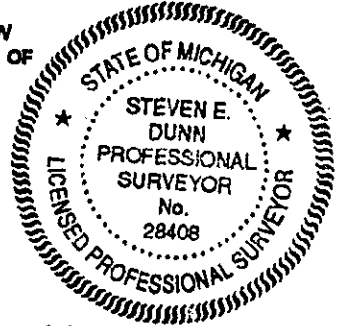

C. Description of monument for corner and accessories established to perpetuate locating the position of the corner:

G-11 T.2N., R.13E. I REPLACED 1/2" IRON ROD WITH 3/4" x 24" IRON ROD WITH 2" DIAMETER ALUMINUM CAP STAMPED "MACOMB COUNTY MONUMENT MI. ACT 345 #28408" IN AN EXISTING MONUMENT BOX.

WITNESSES

- N.26°W. 76.87' SET PK NAIL WITH M.C.R. WITNESS TAG IN SOUTHWEST FACE OF UTILITY POLE
- N.41°E 72.25' SET PK NAIL WITH M.C.R. WITNESS TAG IN NORTHWEST FACE OF UTILITY POLE
- S.43°E. 44.75' SET PK NAIL WITH M.C.R. WITNESS TAG IN NORTHEAST FACE OF UTILITY POLE
- S.75°W. 48.55' FOUND 2-HEADED NAIL AND CAP IN NORTHWEST FACE OF UTILITY POLE
- S.65°E. 65.66' CENTER TOP NUT ON FIRE HYDRANT

THE SELECTED LOCATION IS ACCEPTED BY ME AND IS GENERALLY ACCEPTED BY PROFESSIONAL SURVEYORS AS THE BEST AVAILABLE EVIDENCE OF THE POSITION OF THE ORIGINAL CORNER.

Signed by Steven E. Dunn Date Dec 20, 1994
Surveyor's Michigan License No. 28408