

# SURVEY & REMONUMENTATION

APR 28 1995

C152231

COMMISSION

**LAND CORNER RECORDATION CERTIFICATE**  
Filing Requirement of Act 74, Mich. P.A. 1970

94 DEC 14 AM 10:52

For corners in  
MACOMB  
(County)

Located In: Clinton Township Corner Code H-1

DANIEL  
RECORDS  
MACOMB COUNTY, MI

- |                                    |             |              |         |  |  |
|------------------------------------|-------------|--------------|---------|--|--|
| 1. Public Land Survey              | T <u>2N</u> | R <u>13E</u> |         |  |  |
|                                    | T _____     | R _____      |         |  |  |
|                                    | T _____     | R _____      |         |  |  |
|                                    | T _____     | R _____      |         |  |  |
| 2. Property Controlling in Section | S _____     | T _____      | R _____ |  |  |
|                                    | S _____     | T _____      | R _____ |  |  |
| 3. Miscellaneous Property in Sec.  | S _____     | T _____      | R _____ |  |  |
|                                    | S _____     | T _____      | R _____ |  |  |

LIBER **6527** PAGE **808**

Register of Deeds Stamp & File Number

4. Lot No. \_\_\_\_\_, Recorded Plat \_\_\_\_\_
5. Private Claims \_\_\_\_\_

	A	B	C	D	E	F	G	H	I	J	K	L	M
2		6	5	4	3	2	1						
3													
4		7	8	9	10	11	12						
5													
6		18	17	16	15	14	13						
7													
8		19	20	21	22	23	24						
9													
10		30	29	28	27	26	25						
11													
12		31	32	33	34	35	36						
13													

I, Randy Kolehouse, in a field survey on Sept. 28, 1994, do hereby certify that under requirements of P.A. 74, Michigan P.A. of 1970, the corner points mentioned in lines 1 and 2 above were in conformance with regulations and rules therefore as required in the current manual of survey instructions of the United States Department of the Interior, Bureau of Land Management or by a decree of a Court of Law and/or that the corner points mentioned in lines 3, 4 and 5 above were in conformance with the rules of the Michigan Board of Land Surveyors or by a Decree of a Court of Law; established, re-established, monumented, re-monumented, recovered, found as expressed below:

**NOTE: Not more than 4 corners, all in the same town and range, may be recorded on this certificate.**

**A. Description of original monument and accessories and/or subsequent restoration:**

H-1	1817	G.L.O.	Notes	Wampler	NA	Post
			Enterprise Industrial Sub. L. 85 Plats P 1			NA
			No other information on record.			

**B. Description of corner evidence found and/or method applied in restoring or reestablishing corner:**

H-1 Enterprise Industrial Sub. shows dist. of 2797.59 West to G-1, no description of corner and no witnesses. G.L.O. set post at midpoint of section line. Decided to set H-1 at midpoint on line between H-13 and I-13 T3N R13E. Measure West 577.09' to H-13 T3N R13E (G.L.O. 574.2)

Measure E 2679.45 to I-1 (G.L.O. 2640)  
Measure W 2679.45 to G-1 (G.L.O. 2640)

ACCEPTED BY THE MACOMB COUNTY SURVEY PEER GROUP AS THE OFFICIAL CORNER UNDER MICHIGAN PUBLIC ACT 345 OF 1990 AT A MEETING HELD ON 10-4-94

*William E. Soderberg*  
WILLIAM E. SODERBERG, P.S., CHAIRMAN


This point is 118.14 West of N 1/4 Section 3 as shown in Enterprise Industrial Sub.

**C. Description of monument for corner and accessories established to perpetuate locating the position of the corner:**

H-1 I replaced a 3/4" x 24" Iron Rod w/2" diameter aluminum cap stamped "Macomb County Monument MI Act 345 #25854," also set Monument Box.

- PK & Macomb Co. Remon. Tag in W Face Util. Pole S 19° E 64.78'
- PK & Macomb Co. Remon. Tag in NW Face Util. Pole S 50° W 130.10'
- PK & Macomb Co. Remon. Tag in SW Face 12" Maple N 38° W 96.29'
- PK & Macomb Co. Remon. Tag in W Face 15" Oak N 08° E 71.34'
- PK & Macomb Co. Remon. Tag in NW Face 15" Pine N38° E 107.96'
- Top C/L Hyd S 12° E 45.12'

The selected location is accepted by me and is generally accepted by professional surveyors as the best available evidence of the position of the original corner.

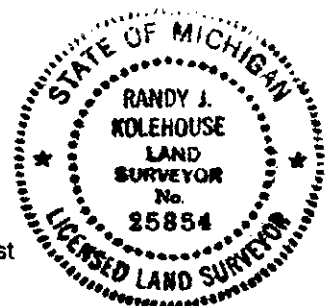

Signed by Randy J. Kolehouse  
Surveyor's Michigan License No. 25854

Date 10/14/94