

LAND CORNER RECORDATION CERTIFICATE
Filing Requirement of Act 74, Mich. P.A. 1970

MAR 17 2000


For corners in

<u>Macomb</u> (County)	Located In: Clinton Twp.	Corner Code # <u>I-09</u>
1. Public Land Survey	T <u>2N</u> R <u>13E</u>	
	T _____ R _____	
	T _____ R _____	
	T _____ R _____	
2. Property Controlling in Section	S _____ T _____ R _____	
	S _____ T _____ R _____	
3. Miscellaneous Property in Sec.	S _____ T _____ R _____	
	S _____ T _____ R _____	
4. Lot No. _____, Recorded Plat _____		
5. Private Claims _____		

SECTION

1177
LIBER 9275 PAGE 529
01/04/2000 09:29:27 A.M.
MACOMB COUNTY, MI
CARNELLA SABAUGH, REG/DEEDS

Register of Deeds Stamp & File
Number

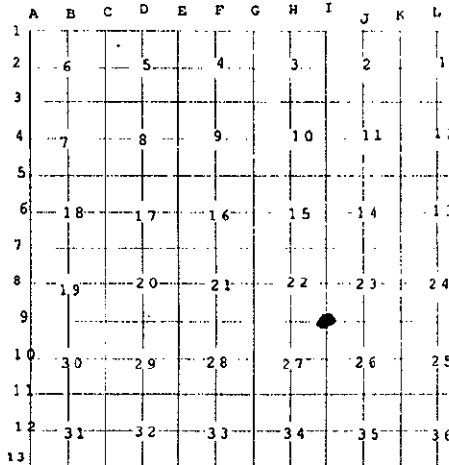

I, Michael S. Hoben in a field survey on April 16, 1999 do hereby state that under requirements of P.A. 74, Michigan P.A. of 1970, the corner points mentioned in lines 1 and 2 above were in conformance with regulations and rules therefore as required in the current manual of survey instructions of the United States Department of the Interior, Bureau of Land Management or by a decree of a Court of Law and /or that the corner points mentioned in lines 3, 4 and 5 above were in conformance with the rules of the Michigan Board of Land Surveyors or by a Decree of a Court of Law; established, re-established, monumented, recovered, found as expressed below:

NOTE: Not more than 2 corners, all in the same town and range, may be recorded on this certificate.

A. Description of original monument and accessories and/or subsequent restoration:

I-091817 GLO Notes	Wampler	NA	Post
1916 "Meadowlawn Sub"	L.3, P. 33	NA	
1945 "Ingleside Farms"	L.23, P.7	NA	
1945 "Ingleside Farms 1"	L.23, P.14	NA	
1946 "Ingleside Farms 2"	L.23, P.27	NA	
1946 "Nunneley Woods Sup"	L.24, P.6	NA	
1956 "Harper Metropolitan Parkway"	L.35, P.14	NA	
1977 MDOT witnesses	NA	NA	
1977 LCRC L.2872, P.63	Douglas W. Hooth	7966	Pointed rock
1998 LCRC L.8435, P.784	Robert L. Smith	16052	Pointed rock

B. Description of corner evidence found and/or method applied in restoring or reestablishing corner:

I-09 Found a pointed stone approx. 1.5' dia. In the median of Metro Parkway (conc.) about 120' east of Gratiot Ave. (conc.) centerline.
Distance to J-09 (2693.34' record 1977 MDOT) (2640' R GLO) (2693.16' M)
Distance to H-09 (2707.11' record 1977 MDOT) (2643.3' R GLO) (2706.98' M)
Distance to I-10 (2640' R GLO) (2734.64' M)


LCRC L.2872, P63, LCRC L. 8435, P.784 & 1977 MDOT witnesses
NE 15.09' 9" twin Apple (4.99' M).
NE 28.85' Found mag. nail south side clump of Apple trees (28.86' M).
South 95.40' B/c north side E.B. Metro Parkway 95.56' M)
NW 55.05' Southeast corner of stone planter (55.08' M)
NW 50.55' South face 12" Birch (50.43' M)
NW 32.70' Found mag nail east side 14" Apple (32.69' M)
Lot irons in "Nunneley Woods Sub" agree with the found corner I-09

ACCEPTED BY THE MACOMB COUNTY SURVEY PEER GROUP AS THE OFFICIAL CORNER UNDER MICHIGAN PUBLIC ACT 345 OF 1990 AT A MEETING HELD ON 10/26/99
William E. Soderberg
WILLIAM E. SODERBERG, P.S., CHAIRMAN

C. Description of monument for corner and accessories established to perpetuate locating the position of the corner:

I-09 Replaced the pointed stone with a 4" x 48" concrete monument w/2" diameter aluminum cap stamped "Macomb County Monument MI Act345 #35994"

N 33° E 14.99'	Set mag. nail w/Remon tag west face of 9" twin Apple.
N 84° E 28.86'	Found mag. nail south side clump of Apple trees.
South 95.56'	B/c north side E.B. Metro Parkway
N 87° W 55.08'	Southeast corner of stone planter
N 42° W 50.43'	Set mag. nail w/MCR tag south face 12" Birch
N 20° W 32.69'	Found mag nail east side 14" Apple

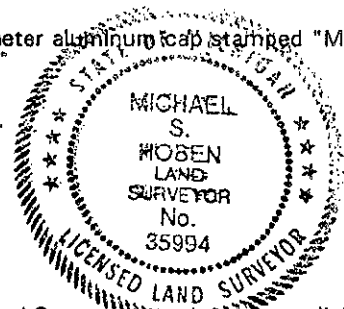

The selected location is accepted by me and is generally accepted by Professional Surveyors as the best available evidence of original corner.

Signed by Michael S. Hoben Date Mar 27, 19
Surveyor's Michigan License No. 35994 FORM APPROVED BY MICHIGAN STATE BOARD OF LAND SURVEYORS, JAN. 28, 1971

929