

**SURVEY &
REMONUMENTATION**

APR 28 1995

C152233

**LAND CORNER RECORDATION CERTIFICATE
Filing Requirement of Act 74, Mich. P.A. 1970**

94 DEC 14 AM 10:52

COMMISSION

For corners in

MACOMB

(County)

Located In: **Clinton
Township**

Corner Code #

CASE
REGISTERED
MACOMB COUNTY, MI
LAUGH
DEEDS
COUNTY, MI

- | | | |
|---------------------------------------|--------------------------|------------|
| 1. Public Land Survey | T <u>2N</u> R <u>13E</u> | <u>J-1</u> |
| | T _____ R _____ | _____ |
| | T _____ R _____ | _____ |
| | T _____ R _____ | _____ |
| 2. Property Controlling
in Section | S _____ T _____ R _____ | _____ |
| | S _____ T _____ R _____ | _____ |
| 3. Miscellaneous
Property in Sec. | S _____ T _____ R _____ | _____ |
| | S _____ T _____ R _____ | _____ |

LIBFR 6527 PAGE 810

Register of Deeds Stamp & File Number

4. Lot No. _____, Recorded Plat _____
5. Private Claims _____

	A	B	C	D	E	F	G	H	I	J	K	L	M
2	6	5	4	3	2	1							
3													
4	7	8	9	10	11	12							
5													
6	18	17	16	15	14	13							
7													
8	19	20	21	22	23	24							
9													
10	30	29	28	27	26	25							
11													
12	31	32	33	34	35	36							
13													

I, Randy Kolehouse, in a field survey on Sept. 28, 19 94

do hereby certify that under requirements of P.A. 74, Michigan P.A. of 1970, the corner points mentioned in lines 1 and 2 above were in conformance with regulations and rules therefore as required in the current manual of survey instructions of the United States Department of the Interior, Bureau of Land Management or by a decree of a Court of Law and/or that the corner points mentioned in lines 3, 4 and 5 above were in conformance with the rules of the Michigan Board of Land Surveyors or by a Decree of a Court of Law; established, re-established, monumented, re-monumented, recovered, found as expressed below:

NOTE: Not more than 4 corners, all in the same town and range, may be recorded on this certificate.

A. Description of original monument and accessories and/or subsequent restoration:

J-1	1817	G.L.O.	Notes	Preston	NA	Post
	1938	MDOT	Road Plans			NA
	1988	L.C.R.C.	L. 4382 P. 77	Landwehr	#10065	PK Nail
	1989	L.C.R.C.	L. 4685 P. 289	Wetoskey	#19847	Set Iron in Mon. Box

ACCEPTED BY THE MACOMB COUNTY SURVEY PEER GROUP AS THE OFFICIAL CORNER UNDER MICHIGAN PUBLIC ACT 345 OF 1990 AT A MEETING HELD ON 10-4-94

William E. Soderberg
WILLIAM E. SODERBERG, P.S., CHAIRMAN

B. Description of corner evidence found and/or method applied in restoring or reestablishing:

J-1 Found 1/2" rebar in Monument Box 10.9 feet north of the center line of Hall Road (M-59) per the witnesses of above L.C.R.C.'s, 598.63' East of J-13 T3N R13E as monumented in 1993 (G.L.O. 574.2) said iron in monument box is 2082.9' West of K-13 (MDOT = 2082.4)

L.C.R.C. L. 4382 P. 77

L.C.R.C. L. 4685 P. 289

N 30° E 46.2 PK in D.E. Pole
S 30° W 58.5 C/L Fire Hyd.
S 50° W 80.3' PK in D.E. Pole
N 50° W 91.5 C/L Hyd.

N 30° E 46.2 PK in D.E. Pole
S 30° W 58.5 C/L Fire Hyd.
S 50° W 80.3' PK in D.E. Pole
N 50° W 91.5 C/L Hyd.


Measure W 2697.80 to I-1 (G.L.O. 2640)
Measure E 2656.96 to K-1 (G.L.O. 2640)

C. Description of monument for corner and accessories established to perpetuate locating the position of the corner:

J-1 I replaced the found 1/2" rebar with a 3/4" x 24" Iron Rod w/2" diameter aluminum cap stamped "Macomb County Monument MI Act 345 #25854" in an existing Monument Box.

PK in NW Face Util. Pole N 20° E 46.03'
C/L Top Nut of Hyd. N 60° W 91.43'
C/L Top Nut of Hyd. S 28° W 58.52'
PK in SE Face Util. Pole S 35° W 80.22'
PK & Macomb Co. Remon. Tag in NE Face Util. Pole S 53° E 114.08'
C/L Hall Road (M-59) Pavement S 10.9'

The selected location is accepted by me and is generally accepted by professional surveyors as the best available evidence of the position of the original corner.

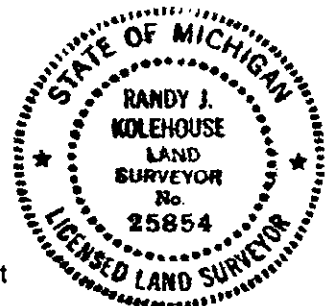

Signed by Randy J. Kolehouse
25854

Date 10/14/94

Surveyor's Michigan License No. _____