

LAND CORNER RECORDATION CERTIFICATE  
Filing Requirement of Act 74, Mich. P.A. 1970

MAR 17 2000

For corners in

SECTION

<u>Macomb</u> (County)	Located In: Clinton Twp.	Corner Code # K-10
1. Public Land Survey	T 2N R 13E	
	T R	
	T R	
	T R	
2. Property Controlling in Section	S T R	
	S T R	
3. Miscellaneous Property in Sec.	S T R	
	S T R	

1170  
LIBER 9275 PAGE 521  
01/04/2000 09:29:18 A.M.  
MACOMB COUNTY, MI  
CARNELLA SABAUGH, REG/DEED

Register of Deeds Stamp & File  
Number

A	B	C	D	E	F	G	H	I	J	K
1										
2	6		5		4			3		2
3										
4	7		8		9			10		11
5										
6	18		17		16			15		14
7										
8	19		20		21			22		23
9										
10	30		29		28			27		26
11										
12	31		32		33			34		35
13										

4. Lot No. \_\_\_\_\_, Recorded Plat \_\_\_\_\_  
5. Private Claims \_\_\_\_\_

I, Michael S. Hoban, in a field survey on Oct. 11, 1999 do hereby state that under requirements of P.A. 74, Michigan P.A. of 1970, the corner points mentioned in lines 1 and 2 above were in conformance with regulations and rules therefore as required in the current manual of survey instructions of the United States Department of the Interior, Bureau of Land Management or by a decree of a Court of Law and /or that the corner points mentioned in lines 3, 4 and 5 above were in conformance with the rules of the Michigan Board of Land Surveyors or by a Decree of a Court of Law; established, re-established, monumented, recovered, found as expressed below:

NOTE: Not more than 2 corners, all in the same town and range, may be recorded on this certificate.

A. Description of original monument and accessories and/or subsequent restoration:

K-10 Post	1817 GLO Notes	Wampler	NA	Set
	1912 "Glenwood Gardens" Plat	L. 2, P. 212 & 213	NA	Not Stated
	1937 "Supervisor's Plat No. 7" Plat	L. 18, P. 47	NA	Not Stated
	1965 "Clinton Harper Sub. No. 2	L. 56, P. 14	NA	Not Stated

B. Description of corner evidence found and/or method applied in restoring or reestablishing corner:

K-10 No evidence of the corner was found in the field.

I reset the corner with a P.K. Nail from irons found in Glenwood Gardens plat and Clinton Harper Sub. No. 2 L. 56, P. 14. The point fell 2.4' East of the West edge of Harper Ave. (asph.) on a fence line to the west.

C. Description of monument for corner and accessories established to perpetuate locating the position of the corner:


K-10 I replaced the set P.K. Nail with a 3/4" x 24" iron rod w/2" diameter aluminum cap stamped "Macomb County Monument MI Act 345 #35994" in a new monument box.

- N 34° E 102.13' Set P.K. Nail w/Remon tag S. face Util. Pole
- S 53° E 79.47' Set P.K. Nail w/Remon tag N. face Util. Pole
- N 80° W 16.97' Set P.K. Nail w/Remon tag S. face Util. Pole
- S 16° W 25.41' Set " + " NE'ly rim Storm M/H
- S 72° W 67.67' NE corner brick house #35971 Harper Ave.

ACCEPTED BY THE MACOMB COUNTY SURVEY PEER GROUP AS THE OFFICIAL CORNER UNDER MICHIGAN PUBLIC ACT 345 OF 1990 AT A MEETING HELD ON 10/26/99

William E. Soderberg  
WILLIAM E. SODERBERG, P.S., CHAIRMAN

The selected location is a careful and faithful re-establishment of the position of the original corner.

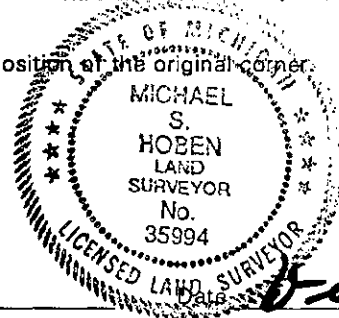

Signed by Michael S. Hoban  
Surveyor's Michigan License No. 35994

FORM APPROVED BY MICHIGAN STATE BOARD OF LAND SURVEYORS, JAN. 28, 1991

REVISED MAY 14, 1991  
REVISED JAN., 1991  
REVISED OCT., 1991

0136