

**SURVEY &
REMONUMENTATION**

C152235

APR 28 1995

LAND CORNER RECORDATION CERTIFICATE
Filing Requirement of Act 74, Mich. P.A. 1970

94 DEC 14 AM 10: 53

For corners in **COMMISSION**
MACOMB
(County)

Located In: **Clinton**
Township Corner Code **#**

CAN... LAUGH
REC... DEEDS
M... M... MI

1. Public Land Survey	T	<u>2N</u>	R	<u>13E</u>	<u>L-1</u>
	T		R		
	T		R		
	T		R		
2. Property Controlling in Section	S		T		R
	S		T		R
3. Miscellaneous Property in Sec.	S		T		R
	S		T		R

LIBER **6527** PAGE **812**

Register of Deeds Stamp & File Number

4. Lot No. _____, Recorded Plat _____
5. Private Claims _____

	A	B	C	D	E	F	G	H	I	J	K	L	M
2	6	5	4	3	2	1							
3													
4	7	8	9	10	11	12							
5													
6	18	17	16	15	14	13							
7													
8	19	20	21	22	23	24							
9													
10	30	29	28	27	26	25							
11													
12	31	32	33	34	35	36							
13													

I, Randy Kolehouse, in a field survey on Sept. 28, 1994, do hereby certify that under requirements of P.A. 74, Michigan P.A. of 1970, the corner points mentioned in lines 1 and 2 above were in conformance with regulations and rules therefore as required in the current manual of survey instructions of the United States Department of the Interior, Bureau of Land Management or by a decree of a Court of Law and/or that the corner points mentioned in lines 3, 4 and 5 above were in conformance with the rules of the Michigan Board of Land Surveyors or by a Decree of a Court of Law; established, re-established, monumented, re-monumented, recovered, found as expressed below:

NOTE: Not more than 4 corners, all in the same town and range, may be recorded on this certificate.

A. Description of original monument and accessories and/or subsequent restoration:

L-1	1817	G.L.O.	Notes	Preston	NA	Set Post
	1980	Cart. Survey	L. 3293 P. 830	Soderberg	#17635	Set PK Nail
	1980	L.C.R.C.	L. 3263 P. 895	Soderberg	#17635	Set PK Nail
	1989	L.C.R.C.	L. 4795 P. 487	Avey	#15396	PK Nail
	1989	L.C.R.C.	L. 4685 P. 293	Wetoskey	#19847	Fnd. PK/Set Mon. Box
	1989	L.C.R.C.	L. 4718 P. 609	Soderberg	#17635	Fnd. Mon. Box/Set Form Pin Inside

B. Description of corner evidence found and/or method applied in restoring or reestablishing corner:

L-1 Found 1/2" rebar in monument box in center line of Hall Road (M-59) on East right-of-way line ± Fairchild this point is 560.01' East of L-13 T3N R13E (G.L.O. 574.2) which checks MDOT Dist. of 559.96 (Grid) from 1989. The corner as shown in L. 3263 P. 895 and L. 4795 P. 487 is approximately 276 feet West. 1/2" iron in Mon. Box checks three remaining witnesses from L.C.R.C. L. 4685 P. 293 as filed by Wetoskey of MDOT. This point is 0.63' North of Township line.

Note: Mon. box and form pin shown in L. 4718 P. 609 is at L-13 T3N R13E. (560.1 West)

L.C.R.C. L. 4685 P. 293

- Nail & tag in P. Pole S 50° E 82.39'
- NE Corner Fr. Hse. S 40° W 111-53'
- Nail & tag in P & L Pole N 40° W 80.59'

Measure West 2638.65' to K-1 (G.L.O. 2640)

Measure East 2128.96' to approximate Township corner (3/4" pipe) (G.L.O. 2065.8')

ACCEPTED BY THE MACOMB COUNTY SURVEY PEER GROUP AS THE OFFICIAL CORNER UNDER MICHIGAN PUBLIC ACT 345 OF 1990 AT A MEETING HELD ON 10-4-94


William E. Soderberg
WILLIAM E. SODERBERG, P.S., CHAIRMAN

C. Description of monument for corner and accessories established to perpetuate locating the position of the corner:

L-1 I replaced the found 1/2" rebar and Monument Box with a 3/4" x 24" Iron Rod w/2" diameter aluminum cap stamped "Macomb County Monument MI Act 345 #25854" on the Township line, also set Monument Box.

- PK & Macomb Co. Remon. Tag in E Face Util. Pole N 08° W 236.66'
- Nail & MDOT Tag SW Face Util. Pole N 40° W 81.00'
- Nail & MDOT Tag NE Face Util. Pole S 41° E 81.96'
- Nail & MDOT Tag SE Face Util. Pole S 54° W 82.03'
- NW Corner Apt. Bldg. 24068 S 48° W 111.02'
- NW Corner Apt. Bldg. 24100 S 24° E 127.32'

- C/L Top Nut Hyd. N 72° E 179.38'
- C/L Top Nut Hyd. S 29° E 97.97'

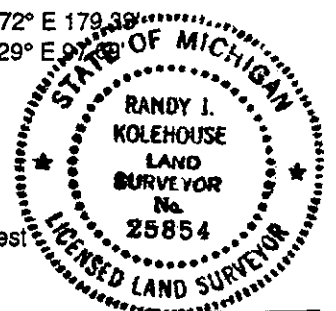

The selected location is accepted by me and is generally accepted by professional surveyors as the best available evidence of the position of the original corner.

Signed by Randy J. Kolehouse
Surveyor's Michigan License No. 25854

Date 10/14/94