



# CARMELLA SABAUGH


Macomb County Clerk/Register of Deeds

10 North Main Street, 2nd Floor • Mount Clemens, MI 48043

Office Phone: (810) 469-7916 • Cellular Phone: (810) 530-3399 • Fax: (810) 469-5130

Shelby Township T3N, R12E

*Macomb County Rezonementation Program  
William E. Soderberg, Surveyor Representative*

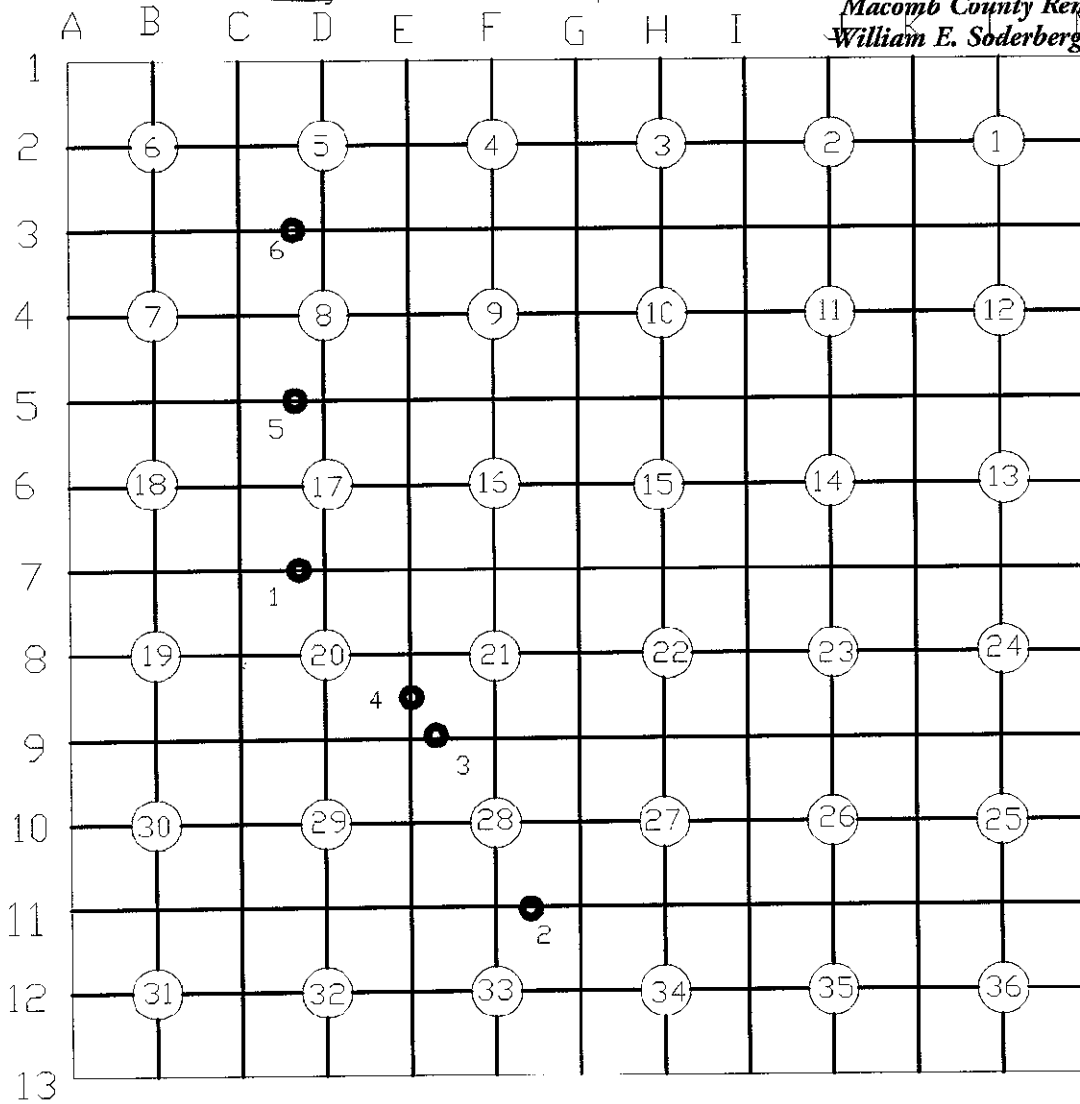

## PROPERTY CONTROLLING CORNERS

- 1 WEST OF D-7 L8436 P183
- 2 EAST OF F-11 L8436 P184
- 3 EAST OF E-9 L8436 P185
- 4 NORTH OF E-9 L8436 P186
- 5 EAST OF C-5 L
- 6 EAST OF C-3 L

**SURVEY &  
REMONUMENTATION**

**MAR 17 2000**

**SECTION**