50

Micomb Co.

Form 974.

T. 3 N R. 12 E Mer.

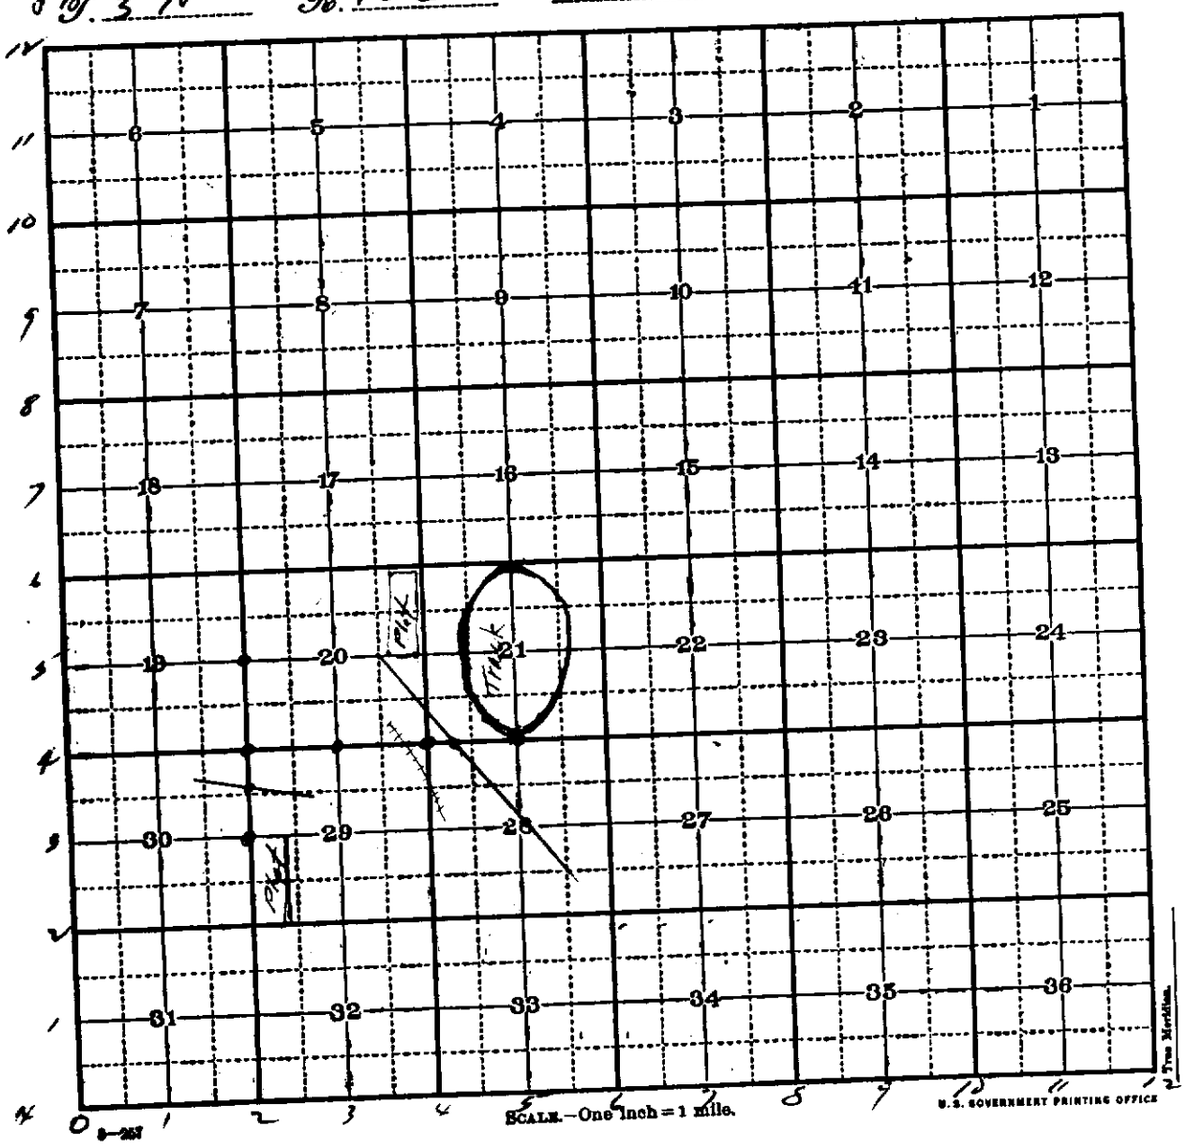

U.S. GOVERNMENT PRINTING OFFICE

8—267

y