

LAND CORNER RECORDATION CERTIFICATE
Filing Requirement of Act 74, Mich. P.A. 1970

1091844
 LIBER 9268 PAGE 32
 12/27/1999 01:16:06 P.M.
 MACOMB COUNTY, MI
 CARMELLA SABAUGH, REG/DEEDS

For corners in <u>Macomb</u> (County)	Located In: Shelby Twp.	Corner Code #
1. Public Land Survey	T <u>3N.</u> R <u>12E.</u>	<u>B-5</u>
	T _____ R _____	_____
	T _____ R _____	_____
	T _____ R _____	_____
2. Property Controlling in Section	S _____ T _____ R _____	_____
	S _____ T _____ R _____	_____
3. Miscellaneous Property in Sec.	S _____ T _____ R _____	_____
	S _____ T _____ R _____	_____

Register of Deeds Stamp & File Number

4. Lot No. _____, Recorded Plat _____
 5. Private Claims _____

I, Jeffrey A. Wright, in a field survey on 24 August, 19 99 do hereby state that under requirements of P.A. 74, Michigan P.A. of 1970, the corner points mentioned in lines 1 and 2 above were in conformance with regulations and rules therefore as required in the current manual of survey instructions of the United States Department of the Interior, Bureau of Land Management or by a decree of a Court of Law and/or that the corner points mentioned in lines 3, 4 and 5 above were in conformance with the rules of the Michigan Board of Land Surveyors or by a Decree of a Court of Law; established, re-established, monumented, recovered, found as expressed below:

NOTE: Not more than 2 corners, all in the same town and range, may be recorded on this certificate.

	A	B	C	D	E	F	G	H	I	J	K	L	M
1													
2		6	5	4	3	2	1						
3													
4		7	8	9	10	11	12						
5													
6		18	17	16	15	14	13						
7													
8		19	20	21	22	23	24						
9													
10		30	29	28	27	26	25						
11													
12		31	32	33	34	35	36						
13													

A. Description of original monument and accessories and/or subsequent restoration:

Date	Surveyor	Number	Type	L.	P.	Monument Box
1817	Wampler		Set Post			GLO Records No
1982	Soderberg	17635	f. PK nail Act 74	3551	372	No
1988	Fenn	23505	f. 1/2" bar Act 74	4420	934	No


B. Description of corner evidence found and/or method applied in restoring or reestablishing corner:

Found remains of unknown nail that agreed w/witnesses from L. 4420, P. 934.

Location supported by corners in:

Huntington Park Sub.	L. 37, P. 20
Gaskill Acres	L. 38, P. 10-11
Brookfield Meadows Sub. #1	L. 44, P. 49
Towering Oaks Sub. #6	L. 47, P. 12
Huntington Park Sub. #2	L. 50, P. 13
Hill-N-Brook Sub.	L. 56, P. 47
Fox Hill Sub. #1	L. 59, P. 33
Huntington Park Sub. #3	L. 62, P. 41

Ground Distances:

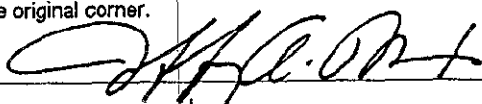
B-5 to C-5 = 2642.27' m.
 GLO: B-5 to C-5 = 40.00 ch. (2640')
 ACCEPTED BY THE MACOMB COUNTY SURVEY PEER GROUP AS THE OFFICIAL CORNER UNDER MICHIGAN PUBLIC ACT 345 OF 1890 AT A MEETING HELD ON 9/28/99

 WILLIAM E. SODERBERG, P.S., CHAIRMAN

C. Description of monument for corner and accessories established to perpetuate locating the position of the corner:

Replaced remains of unknown nail w/3/4" bar with an aluminum cap stamped "Macomb County Monument - MI Act 345 #40165" in a new monument box.

- (AZ. 315°) 35.46' to Mag nail w/Macomb County Witness Tag NE side U. pole
- (AZ. 27°) 37.94' to Mag nail w/Macomb County Witness Tag W. side U. pole 3' A.G.L.
- (AZ. 228°) 38.95' to Mag nail w/Macomb County Witness Tag SE side U. pole
- (AZ. 179°) 53.73' to Mag nail w/Macomb County Witness Tag W. side U. pole

The selected location is accepted by me and is generally accepted by Professional Surveyors as the best available evidence of the position of the original corner.

Signed by 
 Surveyor's Michigan License No. 40165

Date: 9 DECEMBER 1999

