

# SURVEY & REMONUMENTATION

APR 28 1995

C152202

## LAND CORNER RECORDATION CERTIFICATE COMMISSION Filing Requirement of Act 74, Mich. P.A. 1970

corners in  
MACOMB (County) Located In: Shelby Township Corner Code #B-13

Public Land Survey	T <u>3N</u> R <u>12E</u>	<u>B-13</u>
	T _____ R _____	_____
	T _____ R _____	_____
	T _____ R _____	_____
Property Controlling in Section	S _____ T _____ R _____	_____
Miscellaneous	S _____ T _____ R _____	_____
Property in Sec.	S _____ T _____ R _____	_____

LIBER **6527** PAGE **779**


94 DEC 11 AM 10:50

SARREGIE MACOMB COUNTY, MI DEEDS

**Register of Deeds Stamp & File Number**

Lot No. \_\_\_\_\_, Recorded Plat \_\_\_\_\_  
Private Claims \_\_\_\_\_

Randy Kolehouse, in a field survey on Aug. 10, 19 94, hereby certify that under requirements of P.A. 74, Michigan P.A. of 1970, the corner points mentioned in lines 1 and 2 above were in conformance with regulations and rules therefore as required in the present manual of survey instructions of the United States Department of the Interior, Bureau of Land Management or by a decree of a Court of Law and/or that the corner points mentioned in lines 3, 4 and 5 above were in conformance with the rules of the Michigan Board of Land Surveyors or by a Decree of a Court of Law; established, re-established, monumented, re-monumented, recovered, found as crossed below:

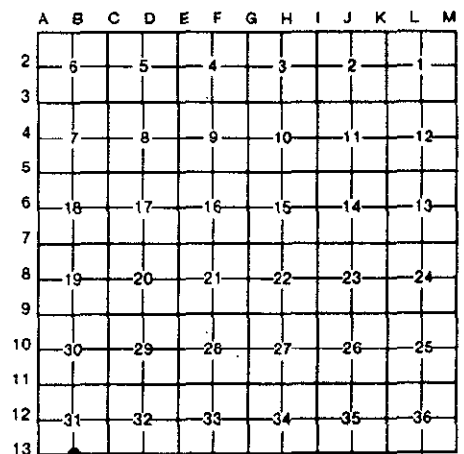

**NOTE: Not more than 4 corners, all in the same town and range, may be recorded on this certificate.**

Description of original monument and accessories and/or subsequent restoration:

-13	1817	G.L.O.	Notes	Wampler	NA	Post
	1987	L.C.R.C.	L. 4375 P. 725			Conc. Mon. (B1 T2N R12E)
	1988	L.C.R.C.	L. 4507 P. 851	Spencer	#13044	Metal Disk in 4" Conc. Mon.
	1989	L.C.R.C.	L. 4665 P. 607	Patterson	#17631	Conc. Mon. in Berm M-59
	1990	L.C.R.C.	L. 4854 P. 208	Patterson	#17631	Iron (B1 T2N R12E)

Description of corner evidence found and/or method applied in restoring or reestablishing corner:

- 13 Found 4" concrete monument in median of M-59. Monument has brass disc (no markings). Checks following.
  - L.C.R.C. L. 4375 P. 725
    - Edge of W.B. M-59 Pave. N 9.00'
    - Edge E.B. M-59 Pave. S 61.00'
  - L.C.R.C. L. 4854 P. 208
    - Sta. 548+00 N 50° W 106.41'
    - Sta. 549+00 N 10° W 32.02'
    - Sta. 550+00 N 70° E 100.95'
  - L.C.R.C. L. 4507 P. 1385
    - + Sta. 550+00 W.B. M-59 N 83° E 100.95'
    - + Sta. 549+00 W.B. M-59 N 10° E 32.02'
    - + Sta. 549+00 E.B. M-59 S 15° W 83.93'
    - + Sta. 550+00 E.B. M-59 S 35° E 127.75'
  - L.C.R.C. L. 4665 P. 607
    - Edge E.B. Conc. M-59 S 61.00'
    - Edge W.B. Conc. M-59 N 9.00'

Measure W 2644.56 to A-13  
Measure E 2651.98 to C-13 (L.C.R.C. L. 4665 P. 607 - 2652.02) (G.L.O. 2640)  
This corner is common with B-1 T2N R12E

Description of monument for corner and accessories established to perpetuate locating the position of the corner:

- 13 Replace 4" concrete monument with brass disk in center line median M-59 with 4" concrete monument with aluminum cap stamped "Macomb County Monument MI Act 345 #25854."
  - + Station 548+00 W.B. Pavement M-59 N 58° W 106.41
  - + Station 549+00 W.B. Pavement M-59 N 10° E 32.02'
  - + Station 550+00 W.B. Pavement M-59 N 85° E 100.91'
  - + Station 550+00 E.B. Pavement M-59 S 35° E 127.75'
  - + Station 549+00 E.B. Pavement M-59 S 16° W 83.93'
  - + N End 12" RCP N 83° W 104.05'

The selected location is accepted by me and is generally accepted by professional surveyors as the best available evidence of the position of the original corner.

Recorded by Randy J. Kolehouse Date 10/14/94  
Surveyor's Michigan License No. 25854

ACCEPTED BY THE MACOMB COUNTY SURVEY PEER GROUP AS THE OFFICIAL CORNER UNDER MICHIGAN PUBLIC ACT 345 OF 1980 AT A MEETING HELD ON 9-20-94  
William E. Soderberg  
WILLIAM E. SODERBERG, P.S., CHAIRMAN

