

SURVEY & REMONUMENTATION

APR 28 1995

LAND CORNER RECORDATION CERTIFICATE
Filing Requirement of Act 74, Mich. P.A. 1970

C152188

or corners in **COMMISSION**

<u>Macomb</u> <small>(County)</small>	Located In: <u>Shelby</u> Twp.	Corner Code # <u>C-1</u>
Public Land Survey	T <u>3N</u> R <u>12E</u>	<u>C-1</u>
	T _____ R _____	_____
	T _____ R _____	_____
	T _____ R _____	_____
Property Controlling	S _____ T _____ R _____	_____
in Section	S _____ T _____ R _____	_____
Miscellaneous	S _____ T _____ R _____	_____
Property in Sec.	S _____ T _____ R _____	_____

LIBER **6527** PAGE **765**

94 DEC 14 AM 10:49

REGISTER OF DEEDS STAMP & FILE NUMBER
MACOMB COUNTY, MI

Lot No. _____, Recorded Plat _____
Private Claims _____

	A	B	C	D	E	F	G	H	I	J	K	L	M
2	6	5	4	3	2	1							
3													
4	7	8	9	10	11	12							
5													
6	18	17	16	15	14	13							
7													
8	19	20	21	22	23	24							
9													
10	30	29	28	27	26	25							
11													
12	31	32	33	34	35	36							
13													

Huston K. Kennedy, in a field survey on August 15, 1994, hereby certify that under requirements of P.A. 74, Michigan P.A. of 1970, the corner points mentioned lines 1 and 2 above were in conformance with regulations and rules therefore as required in the current manual of survey instructions of the United States Department of the Interior, Bureau of Land Management or by a decree of a Court of Law and/or that the corner points mentioned in lines 3, 4 and 5 above were in conformance with the rules of the Michigan Board of Land Surveyors or by a Decree of a Court of Law; established, re-established, monumented, re-monumented, recovered, found as pressed below:

NOTE: Not more than 4 corners, all in the same town and range, may be recorded on this certificate.

Description of original monument and accessories and/or subsequent restoration:

1817-GLO Wampler, D.S.; Set Post 10" Black Oak S51°E 21 Links; 18" Black Oak S25°E 80 Links
1.) 1986-Kobs, P.S. #14097; Survey L.3880, Pg.94 - Fnd Chiseled Cross in Concrete Pavement

Description of corner evidence found and/or method applied in restoring or reestablishing corner:

1994 Kennedy Surveying, Inc. - Kennedy, P.S. #17623 - Fnd "X" in concrete in the centerline of 26 Mile Road, which has a concrete surface and in the transition from a divided road to a two lane road, and a tree-fence row extending to the South. The Southeast corner of Section 31 and the Southwest corner of Section 32, T4N, R12E, is located 135.53 feet to the West.

Witnesses from Survey #1 were used to verify the location of Chiseled Cross in Concrete Pavement.

FIELD MEASUREMENT BETWEEN


- C-1 to D-1 2716.42 Feet
- C-1 to B-1 2655.56 Feet
- C-1 to D-13 (Washington Twp.) 2500.50 Feet

ACCEPTED BY THE MACOMB COUNTY SURVEY PEER GROUP AS THE OFFICIAL CORNER UNDER MICHIGAN PUBLIC ACT 345 OF 1990 AT A MEETING HELD ON 9-20-94

William E. Soderberg
WILLIAM E. SODERBERG, P.S., CHAIRMAN

Description of monument for corner and accessories established to perpetuate locating the position of the corner:

D-1 I replaced the found "X" in concrete with a 3/4" x 24" Iron Rod w/2" diameter aluminum cap stamped "Macomb County Monument Act 345 #17623" in a new Monument Box.
S03°E 53.61' Set PK & Remon. Washer West face 12" Oak
S28°W 62.19' Set PK & Remon. Washer NW face 15" Apple
S51°W 73.46' Set PK & Remon. Washer North face 42" Oak
S59°W 111.48' Set PK & Remon. Washer North face 44" Oak

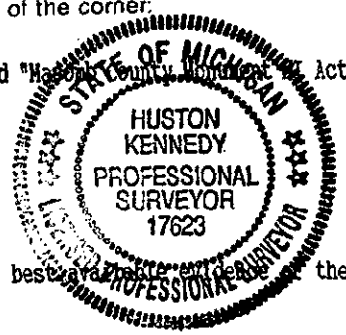

The selected location is accepted by me and is generally accepted by Professional Surveyors as the best available evidence of the position of the original corner.

by *Huston K. Kennedy*
Surveyor's Michigan License No. 17623

Date September 20, 1994