

**SURVEY &
REMONUMENTATION**

C126159

APR 28 1995

COMMISSION

**LAND CORNER RECORDATION CERTIFICATE
Filing Requirement of Act 74, Mich. P.A. 1970**

94 SEP 30 AM 9:01

For corners in


<u>Macomb</u> (County)	Located In: <u>Shelby</u> Township	Corner Code <u>##</u>
1. Public Land Survey	T <u>3</u> N R <u>12</u> E	<u>C-2</u>
	T _____ R _____	_____
	T _____ R _____	_____
	T _____ R _____	_____
2. Property Controlling in Section	S _____ T _____ R _____	_____
	S _____ T _____ R _____	_____
3. Miscellaneous Property in Sec.	S _____ T _____ R _____	_____
	S _____ T _____ R _____	_____

CARMELE A. SABAUGH
REGISTER OF DEEDS
MACOMB COUNTY, MI

118TR **06464PG472**

Register of Deeds Stamp & File Number

4. Lot No. _____, Recorded Plat _____
5. Private Claims _____

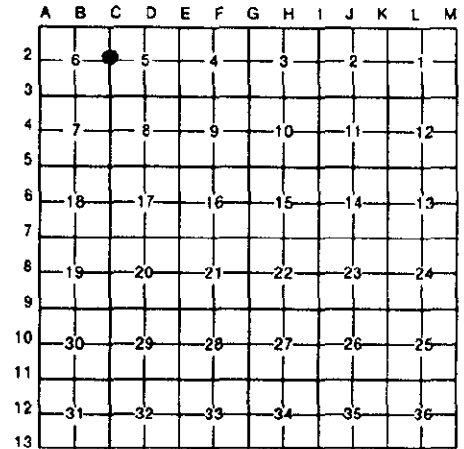

I, Huston K. Kennedy, in a field survey on July 5, 19 94, do hereby certify that under requirements of P.A. 74, Michigan P.A. of 1970, the corner points mentioned in lines 1 and 2 above were in conformance with regulations and rules therefore as required in the current manual of survey instructions of the United States Department of the Interior, Bureau of Land Management or by a decree of a Court of Law and/or that the corner points mentioned in lines 3, 4 and 5 above were in conformance with the rules of the Michigan Board of Land Surveyors or by a Decree of a Court of Law; established, re-established, monumented, re-monumented, recovered, found as expressed below:

NOTE: Not more than 4 corners, all in the same town and range, may be recorded on this certificate.

A. Description of original monument and accessories and/or subsequent restoration:

1817-GLO Wampler, D.S.; Set Post;
1.) 1988-Avey, P.S. #30076; LCRC L.4353, Pg.433 - fnd "T" Bar #123

B. Description of corner evidence found and/or method applied in restoring or reestablishing corner:

1994 Kennedy Surveying, Inc. - Kennedy, P.S. #17623 - Fnd "T" Iron with Cap #123 on the North side of a gas easement with a fence row extending to the North and East.

Witnesses from LCRC #1 were used to recover and verify the location of the found "T" Iron with Cap #123.

FIELD MEASUREMENT BETWEEN

C-2 to C-1 3160.18 Feet
C-2 to C-3 2628.61 Feet

ACCEPTED BY THE MACOMB COUNTY SURVEY PEER GROUP AS THE OFFICIAL CORNER UNDER MICHIGAN PUBLIC ACT 345 OF 1990 AT A MEETING HELD ON 8-16-94
William E. Soderberg
WILLIAM E. SODERBERG, P.S., CHAIRMAN

C. Description of monument for corner and accessories established to perpetuate locating the position of the corner:

C-2 I replaced the found "T" Iron with Cap #123 with a 3/4" x 24" Iron Rod w/2" diameter aluminum cap stamped "Macomb County Monument" MI Act 345 #17623".
N87°W 21.70' Set PK & Remon. Washer SW face 9" Oak
N36°W 29.95' Set PK & Remon. Washer SW face 11" Poplar
N22°E 33.50' Set PK & Remon. Washer SE face 30" Oak
N33°E 10.77' Set PK & Remon. Washer West face 10" Oak

The selected location is accepted by me and is generally accepted by Professional Surveyors as the best available evidence of the position of the original corner.

Signed by [Signature]
Surveyor's Michigan License No. 17623

Date _____

