

LAND CORNER RECORDATION CERTIFICATE
Filing Requirement of Act 74, Mich. P.A. 1970

1091845
 LIBER 9268 PAGE 33
 12/27/1999 01:16:06 P.M.
 MACOMB COUNTY, MI
 CARMELLA SABAUGH, REG/DEEDS

For corners in
Macomb
 (County)

Located In: Shelby Twp.

Corner Code # _____

1. Public Land Survey T 3N. R 12E. C-5
 T _____ R _____
 T _____ R _____
 T _____ R _____

2. Property Controlling in Section S _____ T _____ R _____
 S _____ T _____ R _____

3. Miscellaneous Property in Sec. S _____ T _____ R _____
 S _____ T _____ R _____

4. Lot No. _____, Recorded Plat _____

5. Private Claims _____

ACCEPTED BY THE MACOMB COUNTY SURVEY PEER BOARD AS THE OFFICIAL CORNER UNDER MICHIGAN PUBLIC ACT 345 OF 1990 AT A MEETING HELD ON 9/28/99
 WILLIAM E. SODERBERG, P.S., CHAIRMAN

Register of Deeds Stamp & File Number

I, Jeffrey A. Wright, in a field survey on 24 August, 19 99 do hereby state that under requirements of P.A. 74, Michigan P.A. of 1970, the corner points mentioned in lines 1 and 2 above were in conformance with regulations and rules therefore as required in the current manual of survey instructions of the United States Department of the Interior, Bureau of Land Management or by a decree of a Court of Law and/or that the corner points mentioned in lines 3, 4 and 5 above were in conformance with the rules of the Michigan Board of Land Surveyors or by a Decree of a Court of Law; established, re-established, monumented, recovered, found as expressed below:

1	A	B	C	D	E	F	G	H	I	J	K	L	M
2		6		5		4		3		2		1	
3													
4		7		8		9		10		11		12	
5													
6		18		17		16		15		14		13	
7													
8		19		20		21		22		23		24	
9													
10		30		29		28		27		26		25	
11													
12		31		32		33		34		35		36	
13													

NOTE: Not more than 2 corners, all in the same town and range, may be recorded on this certificate.

A. Description of original monument and accessories and/or subsequent restoration:

Date	Surveyor	Number	Type	L.	P.	Monument Box
1817	Wampler		Set Post	GLO Records		No
1982	Soderberg	17635	f. 5/8" bar Act 74	3551	372	No
1990	Avey	15396	f. 1/2" pipe Act 74	4983	758	Yes

B. Description of corner evidence found and/or method applied in restoring or reestablishing corner:

Found 1/2" pipe in monument box, as previously recorded.

Ground Distances:

Location supported by corners in:

C-5 to B-5 = 2642.27' m.
 GLO: C-5 to B-5 = 40.00 ch. (2640')
 C-5 to D-5 = 2714.95' m.
 GLO: C-5 to D-5 = 40.93 ch. (2701.38')


- Brookside Manor L. 26, P. 3
- Hollands Sub. L. 28, P. 8
- Kuehl Haven Sub. L. 28, P. 32
- Brookfield Meadows L. 37, P. 41
- Gaskill Acres L. 38, P. 10-11
- Towering Oaks Sub. L. 39, P. 1
- Wilseck Manor L. 39, P. 49
- Towering Oaks Sub. #3 L. 42, P. 6
- Towering Oaks Sub. #4 L. 42, P. 32

- Brookfield Meadows Sub. #1 L. 44, P. 49
- Towering Oaks Sub. #6 L. 47, P. 12
- Country Lane Est. L. 48, P. 23-24
- Rhoades Sub. L. 49, P. 7
- Towering Oaks Sub. #2 L. 49, P. 16
- Hill-N-Brook Sub. L. 56, P. 47

C. Description of monument for corner and accessories established to perpetuate locating the position of the corner:

Replaced 1/2" pipe in monument box w/3/4" bar with an aluminum cap stamped "Macomb County Monument - MI Act 345 #40165" in said monument box.

- (AZ. 175°) 34.35' to Mag nail w/Macomb County Witness Tag W. side 20" oak
- (AZ. 225°) 50.53' to Mag nail w/Macomb County Witness Tag NW side 24" oak
- (AZ. 55°) 67.33' to Mag nail w/Macomb County Witness Tag SE side U. pole
- (AZ. 326°) 58.88' to Mag nail w/Macomb County Witness Tag SW side 46" oak

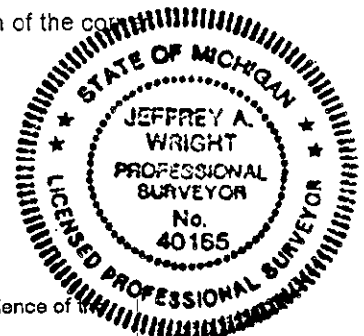

The selected location is accepted by me and is generally accepted by Professional Surveyors as the best available evidence of the position of the original corner.

Signed by [Signature]
 Surveyor's Michigan License No. 40165

Date: 9 DECEMBER 1999