

**LAND CORNER RECORDATION CERTIFICATE**  
**Filing Requirement of Act 74, Mich. P.A. 1970**

1091846  
 LIBER 9268 PAGE 34  
 12/27/1999 01:16:06 P.M.  
 MACOMB COUNTY, MI  
 CARMELLA SABAUGH, REG/DEEDS

For corners in	Located In:	Corner Code #
<u>Macomb</u>	<u>Shelby Twp.</u>	
(County)		
1. Public Land Survey	T <u>3N.</u> R <u>12E.</u>	<u>D-5</u>
	T _____ R _____	_____
	T _____ R _____	_____
	T _____ R _____	_____
2. Property Controlling in Section	S _____ T _____ R _____	_____
	S _____ T _____ R _____	_____
3. Miscellaneous Property in Sec.	S _____ T _____ R _____	_____
	S _____ T _____ R _____	_____

Register of Deeds Stamp & File Number

4. Lot No. \_\_\_\_\_, Recorded Plat \_\_\_\_\_  
 5. Private Claims \_\_\_\_\_

ACCEPTED BY THE MACOMB COUNTY SURVEY PEER GROUP AS THE OFFICIAL CORNER UNDER MICHIGAN PUBLIC ACT 345 OF 1990 AT A MEETING HELD ON 9/28/99  
*William E. Soderberg*  
 WILLIAM E. SODERBERG, P.S., CHAIRMAN

I, Jeffrey A. Wright in a field survey on 24 August, 19 99 do hereby state that under requirements of P.A. 74, Michigan P.A. of 1970, the corner points mentioned in lines 1 and 2 above were in conformance with regulations and rules therefore as required in the current manual of survey instructions of the United States Department of the Interior, Bureau of Land Management or by a decree of a Court of Law and/or that the corner points mentioned in lines 3, 4 and 5 above were in conformance with the rules of the Michigan Board of Land Surveyors or by a Decree of a Court of Law; established, re-established, monumented, recovered, found as expressed below:

1	A	B	C	D	E	F	G	H	I	J	K	L	M
2		6		5		4		3		2		1	
3													
4		7		8		9		10		11		12	
5													
6		18		17		16		15		14		13	
7													
8		19		20		21		22		23		24	
9													
10		30		29		28		27		26		25	
11													
12		31		32		33		34		35		36	
13													

NOTE: Not more than 2 corners, all in the same town and range, may be recorded on this certificate.

A. Description of original monument and accessories and/or subsequent restoration:

Date	Surveyor	Number	Type	L.	P.	Monument Box
1817	Wampler		Set Post	GLO Records		No
1990	Avey	15396	RR spike Act 74	4983	758	No

B. Description of corner evidence found and/or method applied in restoring or reestablishing corner:

Found R.R. spike in asphalt pavement, as previously recorded.

Ground Distances:

Location supported by corners in:

D-5 to C-5 = 2714.95' m.  
 GLO: D-5 to C-5 = 40.93 ch. (2701.38')  
 D-5 to E-5 = 2696.15' m.  
 GLO: D-5 to E-5 = 40.93 ch. (2701.38')


Brookside Manor Sub.	L. 26, P. 3
Kuehl Haven	L. 28, P. 32
Brookside Manor #3	L. 37, P. 21
Towering Oaks Sub.	L. 39, P. 1
Wilseck Manor	L. 39, P. 49
Wilseck Manor #1	L. 40, P. 17
Towering Oaks Sub. #1	L. 40, P. 18
Towering Oaks Sub. #2	L. 41, P. 34
Towering Oaks Sub. #3	L. 42, P. 6

Towering Oaks Sub. #4	L. 42, P. 32
Starlite Meadows Sub.	L. 45, P. 12
Starlite Meadows Sub. #1	L. 46, P. 17
Rhoades Sub.	L. 49, P. 7
Towering Oaks Sub. #7	L. 49, P. 16
Northfield Estates	L. 49, P. 33

C. Description of monument for corner and accessories established to perpetuate locating the position of the corner:

Replaced RR spike w/3/4" bar with an aluminum cap stamped "Macomb County Monument - MI Act 345 #40165" in a new monument box.

- (AZ. 4°) 54.59' to Mag nail w/Macomb County Witness Tag W. side U. pole
- (AZ. 302°) 57.08' to Mag nail w/Macomb County Witness Tag NE side twin 36" oak
- (AZ. 127°) 66.45' to Mag nail w/Macomb County Witness Tag NE side 24" oak
- (AZ. 163°) 28.20' to Mag nail w/Macomb County Witness Tag W. side triple 8" maple

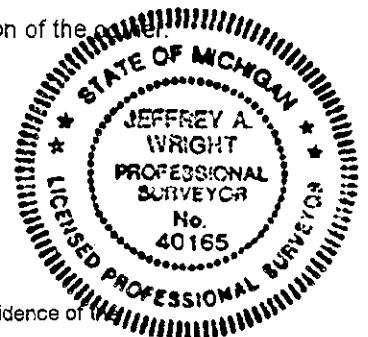

The selected location is accepted by me and is generally accepted by Professional Surveyors as the best available evidence of position of the original corner.

Signed by *Jeffrey A. Wright*  
 Surveyor's Michigan License No. 40165

Date: 9 DECEMBER 1999