

# SURVEY & REMONUMENTATION

APR 28 1995

C152204

## LAND CORNER RECORDATION CERTIFICATE COMMISSION Filing Requirement of Act 74, Mich. P.A. 1970

LIBER 6527 PAGE 781

corners in <b>MACOMB</b> <small>(County)</small>	Located In: <b>Shelby</b> Township	Corner Code <b>#</b>	
Public Land Survey	T <u>3N</u> R <u>12E</u>	<u>D-13</u>	
	T _____ R _____	_____	
	T _____ R _____	_____	
	T _____ R _____	_____	
Property Controlling	S _____ T _____ R _____	_____	
in Section	S _____ T _____ R _____	_____	
Miscellaneous	S _____ T _____ R _____	_____	
Property in Sec.	S _____ T _____ R _____	_____	

94 DEC 14 AM 10:51  
 CLERK OF THE REGISTER  
 REGISTER OF DEEDS  
 MACOMB COUNTY, MI

Register of Deeds Stamp & File Number

Lot No. \_\_\_\_\_, Recorded Plat \_\_\_\_\_  
 Private Claims \_\_\_\_\_

Randy Kolehouse, in a field survey on July 28, 1994, hereby certify that under requirements of P.A. 74, Michigan P.A. of 1970, the corner points mentioned in lines 1 and 2 above were in conformance with regulations and rules therefore as required in the current manual of survey instructions of the United States Department of the Interior, Bureau of Land Management or by a decree of a Court of Law and/or that the corner points mentioned in lines 3, 4 and 5 above were in conformance with the rules of the Michigan Board of Land Surveyors or by a Decree of a Court of Law; established, re-established, monumented, re-monumented, recovered, found as pressed below:

	A	B	C	D	E	F	G	H	I	J	K	L	M
2	6	5	4	3	2	1							
3													
4	7	8	9	10	11	12							
5													
6	18	17	16	15	14	13							
7													
8	19	20	21	22	23	24							
9													
10	30	29	28	27	26	25							
11													
12	31	32	33	34	35	36							
13													

**NOTE: Not more than 4 corners, all in the same town and range, may be recorded on this certificate.**

Description of original monument and accessories and/or subsequent restoration:

-13	1817	G.L.O.	Notes	Wampler	NA	Post
	1989	L.C.R.C.	L. 4606 P. 101	Patterson	#17631	1/2" Iron

Description of corner evidence found and/or method applied in restoring or reestablishing corner:

13 Found 1/2" rebar in right-of-way fence south side of M-59 at approximately Station 41+15.

E Face 14" Ash N 05° W 11.50'  
 W. Face P. Pole N 25° E 71.86'  
 S Face P. Pole N 80° E 80.50'  
 N Face 8" Elm West 15.41'

Measure 2659.76 West to C-13 (G.L.O. 2640)  
 Measure 2635.36 East to E-13 (G.L.O. 2640)

This corner is common with D-1 T2N R12E.


ACCEPTED BY THE MACOMB COUNTY SURVEY PEER  
 GROUP AS THE OFFICIAL CORNER UNDER MICHIGAN  
 PUBLIC ACT 345 OF 1990 AT A MEETING HELD  
 ON 9-20-94

*William E. Soderberg*  
 WILLIAM E. SODERBERG, P.S., CHAIRMAN

Description of monument for corner and accessories established to perpetuate locating the position of the corner:

13 I replaced the found 1/2" rebar with a 3/4" x 24" Iron Rod w/2" diameter aluminum cap stamped "Macomb County Monument MI Act 345 #25854."

PK & Macomb Co. Remon. Tag in E Face 20" Cottonwood N 3° W 11.53'  
 PK & Macomb Co. Remon. Tag in S Face 10" Elm 4 ± Off Ground N 85° W 15.41'  
 PK & Macomb Co. Remon. Tag in S Face Util. Pole N 83° E 80.55'  
 PK & Macomb Co. Remon. Tag in W Face Util. Pole N 18° E 71.87'

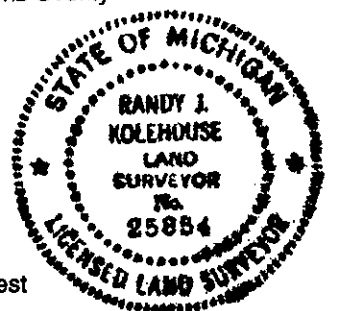

The selected location is accepted by me and is generally accepted by professional surveyors as the best available evidence of the position of the original corner.

Recorded by Randy J. Kolehouse Date 10/14/94  
 Surveyor's Michigan License No. 25854