

**SURVEY &
REMONUMENTATION**

FEB 27 1997

COMMISSION

**LAND CORNER RECORDATION CERTIFICATE
Filing Requirement of Act 74, Mich. P.A. 1970**

For corners in

Macomb (County)	Located In: Shelby Twp.	Corner Code # E-4
1. Public Land Survey	T 3N. R 12E	_____
	T _____ R _____	_____
	T _____ R _____	_____
	T _____ R _____	_____
2. Property Controlling in Section	S _____ T _____ R _____	_____
	S _____ T _____ R _____	_____
3. Miscellaneous Property in Sec.	S _____ T _____ R _____	_____
	S _____ T _____ R _____	_____

ACCEPTED BY THE MACOMB COUNTY SURVEY PEER GROUP AS THE OFFICIAL CORNER UNDER MICHIGAN PUBLIC ACT 345 OF 1990 AT A MEETING HELD ON 7-23-96.

William E. Soderberg
WILLIAM E. SODERBERG, P.S., CHAIRMAN

Register of Deeds Stamp & File Number

4. Lot No. _____, Recorded Plat _____
5. Private Claims _____

I, Jeffrey A. Wright, in a field survey on June 20, 19 96 do hereby state that under requirements of P.A. 74, Michigan P.A. of 1970, the corner points mentioned in lines 1 and 2 above were in conformance with regulations and rules therefore as required in the current manual of survey instructions of the United States Department of the Interior, Bureau of Land Management or by a decree of a Court of Law and/or that the corner points mentioned in lines 3, 4 and 5 above were in conformance with the rules of the Michigan Board of Land Surveyors or by a Decree of a Court of Law, established, re-established, monumented, recovered, found as expressed below:

NOTE: Not more than 2 corners, all in the same town and range, may be recorded on this certificate.

*C0438543 LIBER:07245 PAGE:404 08:59A 11/14/1996
CARMELLA SABAUGH-MACOMB COUNTY, MI REG/DEEDS*

1	A	B	C	D	E	F	G	H	I	J	K	L	M
2		6		5		4		3		2		1	
3													
4		7		8	●	9		10		11		12	
5													
6		18		17		16		15		14		13	
7													
8		19		20		21		22		23		24	
9													
10		30		29		28		27		26		25	
11													
12		31		32		33		34		35		36	
13													

A. Description of original monument and accessories and/or subsequent restoration:

Date	Surveyor	Number	Type	L.	P.	Monument Box
1817	Wampler		Set Post	GLO Records		No
1979	Smith	16052	F. 1/2" Bar	3123	275	Yes
1991	Avey	15396	F. 1/2" Bar	Unrecorded		Yes
1993	MCRC		F. 1/2" Bar	Unrecorded		Unknown

B. Description of corner evidence found and/or method applied in restoring or reestablishing corner:


F. 1/2" Bar in existing monument box in centerline of an asphalt road

Fits call in:	Location supported by corners in:	GLO
L. 3123, P. 275 F. 1/2" Bar	Joyce Sub. L. 54, P. 34	E-4 - E-3 = 2630.92' 2640' / 40 chains
	Falter & Golden Sub. L. 47, P. 39	E-4 - E-5 = 2640.61' 2640' / 40 chains
	Rabbit Creek L. 82, P. 1, 2	
	Wilseck Manor #2 L. 41, P. 33	
	Twilight Sub. #4 L. 58, P. 25, 26	

C. Description of monument for corner and accessories established to perpetuate locating the position of the corner:

Replaced 1/2" Bar in existing monument box with 3/4" Bar with aluminum cap stamped "Macomb County Monument - Michigan #40165"

- AZ 111° 98.93' to Mag nail with remonumentation tag SW side U. Pole
- AZ 138° 85.24' to Mag nail with remonumentation tag SW side 12" Maple
- AZ 22° 83.79' to centerline top hydrant
- AZ 270° 96.17' to Mag nail with remonumentation tag N. side U. Pole
- AZ 328° 94.03' to Mag nail with remonumentation tag SW side 2-10" Maples

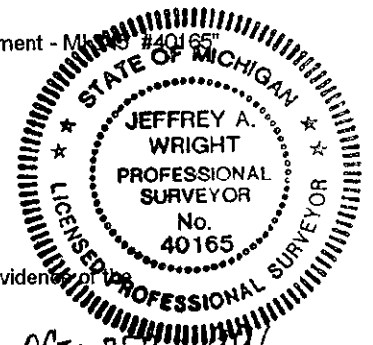

The selected location is accepted by me and is generally accepted by Professional Surveyor's as the best available evidence of the position by the original corner.

Signed by *Jeffrey A. Wright*

Date: 16 OCTOBER 1996

Surveyor's Michigan License No. 40165