

FEB 27 1997

COMMISSION

LAND CORNER RECORDATION CERTIFICATE  
Filing Requirement of Act 74, Mich. P.A. 1970

For corners in

Macomb (County)	Located In: Shelby Twp.	Corner Code #
1. Public Land Survey	T 3N. R 12E.	E-5
	T _____ R _____	_____
	T _____ R _____	_____
	T _____ R _____	_____
2. Property Controlling in Section	S _____ T _____ R _____	_____
	S _____ T _____ R _____	_____
3. Miscellaneous Property in Sec.	S _____ T _____ R _____	_____
	S _____ T _____ R _____	_____

ACCEPTED BY THE MACOMB COUNTY SURVEY PEER GROUP AS THE OFFICIAL CORNER UNDER MICHIGAN PUBLIC ACT 345 OF 1990 AT A MEETING HELD ON 7-23-96

*William E. Soderberg*  
WILLIAM E. SODERBERG, P.S., CHAIRMAN

Register of Deeds Stamp & File Number

4. Lot No. \_\_\_\_\_, Recorded Plat \_\_\_\_\_  
5. Private Claims \_\_\_\_\_

I, Jeffrey A. Wright, in a field survey on June 20, 19 96 do hereby state that under requirements of P.A. 74, Michigan P.A. of 1970, the corner points mentioned in lines 1 and 2 above were in conformance with regulations and rules therefore as required in the current manual of survey instructions of the United States Department of the Interior, Bureau of Land Management or by a decree of a Court of Law and/or that the corner points mentioned in lines 3, 4 and 5 above were in conformance with the rules of the Michigan Board of Land Surveyors or by a Decree of a Court of Law, established, re-established, monumented, recovered, found as expressed below:

NOTE: Not more than 2 corners, all in the same town and range, may be recorded on this certificate.

C0438544 LIBER:07245 PAGE:405 08:59A 11/14/1996  
CARMELLA SABAUGH-MACOMB COUNTY, MI REG/DEEDS

	A	B	C	D	E	F	G	H	I	J	K	L	M
1													
2	6		5		4		3		2		1		
3													
4	7		8		9		10		11		12		
5													
6	18		17		16		15		14		13		
7													
8	19		20		21		22		23		24		
9													
10	30		29		28		27		26		25		
11													
12	31		32		33		34		35		36		
13													

A. Description of original monument and accessories and/or subsequent restoration:

Date	Surveyor	Number	Type	L.	P.	Monument Box
1817	Wampler		Set Post	GLO Records		No
1973	MCRC		Monument	Unrecorded		No
1979	Smith	16052	F. 1/2" Bar	3168	940	Yes
1982	Kobs	14097	F. 1/2" Bar	3421	527	Yes
1986	Avey	30076	F. 1/2" Bar	4080	883	Yes
1987	Fenn	23505	F. 1/2" Bar	4314	503	Yes
1991	Avey	30076	F. 1/2" Bar	Unrecorded		Yes
1991	Avey	15396	F. 1/2" Bar	Unrecorded		Yes

*IN MONUMENT BOX*

B. Description of corner evidence found and/or method applied in restoring or reestablishing corner:


F. 1/2" Bar in existing monument box in asphalt @ road intersection

Fits call in:	Location supported by corners in:	GLO
L. 3168, P. 940 F. 1/2" Bar	Faite & Golden Sub., L. 47, P. 39	E-5 - E-4 = 2640.61' 2640' / 40 chains
L. 3421, P. 527 F. 1/2" Bar	Rabbit Creek, L. 82, P. 1, 2	E-5 - F-5 = 2633.94' 2640' / 40 chains
L. 4080, P. 883 F. 1/2" Bar	Northfield Estates, L. 49, P.33	E-5 - E-6 = 2636.55' 2640' / 40 chains
L. 4314, P. 503 F. 1/2" Bar	Brookside Manor #3, L. 37, P. 21	E-5 - D-5 = 2696.11' 2640' / 40 chains
	Brookside Est. Sub., L. 46, P. 28, 29	

C. Description of monument for corner and accessories established to perpetuate locating the position of the corner

Replaced 1/2" Bar in existing monument box with 3/4" Bar with aluminum cap stamped "Macomb County Monument, MK 945 #40165"

AZ 329° 63.42' to Mag nail with remonumentation tag SW side U. Pole  
 AZ 218° 65.34' to Mag nail with remonumentation tag SE side U. Pole  
 AZ 151° 71.06' to PK with remonumentation tag NE side U. Pole  
 AZ 156° 148.82' to centerline top hydrant  
 AZ 48° 64.10' to PK SE side Guy Pole

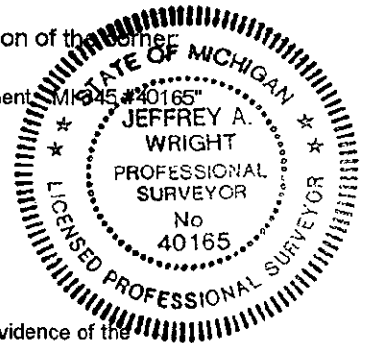

The selected location is accepted by me and is generally accepted by Professional Surveyor's as the best available evidence of the position by the original corner.

Signed by *Jeffrey A. Wright* Date: 16 OCTOBER 1996  
 Surveyor's Michigan License No. 40165

569