

LAND CORNER RECORDATION CERTIFICATE
Filing Requirement of Act 74, Mich. P.A. 1970

For corners in

Macomb (County)	Located In: Shelby Twp.	Corner Code #
1. Public Land Survey	T <u>3N.</u> R <u>12E.</u>	<u>E-8</u>
	T _____ R _____	_____
	T _____ R _____	_____
	T _____ R _____	_____
2. Property Controlling in Section	S _____ T _____ R _____	_____
	S _____ T _____ R _____	_____
3. Miscellaneous Property in Sec.	S _____ T _____ R _____	_____
	S _____ T _____ R _____	_____

SURVEY & REMONUMENTATION

APR 07 1998

ACCEPTED BY THE MACOMB COUNTY SURVEY PEER GROUP AS THE OFFICIAL CORNER UNDER MICHIGAN PUBLIC ACT 345 OF 1990 AT A MEETING HELD ON 7-25-97 SECTION 7-25-97


William E. Soderberg
 WILLIAM E. SODERBERG, P.S., CHAIRMAN

Register of Deeds Stamp & File Number

4. Lot No. _____, Recorded Plat _____
 5. Private Claims _____

I, Jeffrey A. Wright, in a field survey on May 9, 19 97 do hereby state that under requirements of P.A. 74, Michigan P.A. of 1970, the corner points mentioned in lines 1 and 2 above were in conformance with regulations and rules therefore as required in the current manual of survey instructions of the United States Department of the Interior, Bureau of Land Management or by a decree of a Court of Law and/or that the corner points mentioned in lines 3, 4 and 5 above were in conformance with the rules of the Michigan Board of Land Surveyors or by a Decree of a Court of Law; established, re-established, monumented, recovered, found as expressed below:

NOTE: Not more than 2 corners, all in the same town and range, may be recorded on this certificate.

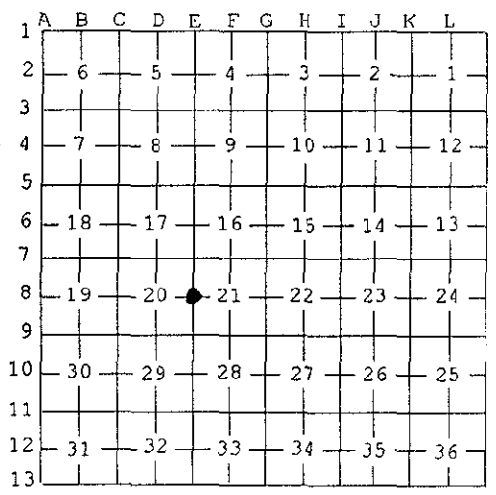

A. Description of original monument and accessories and/or subsequent restoration:

Date	Surveyor	Number	Type	L.	P.	Monument Box
1817	Wampler		Set Post			
1997	Kem-Tec		S. PK Nail	Act 132		
				GLO Records		No
				Unrecorded		No

B. Description of corner evidence found and/or method applied in restoring or reestablishing corner:

No monumentation found

This corner established by adjacent subdivisions and descriptions of record this corner does not fit the corner established by Kem-Tec Engineering Job #97-02602

The N.-S. position determined by parcel #07-02-428-024; the E.-W. position determined by the RW line of "Tientenberg Sub"

Location supported by corners in:	Ground	GLO	Grid
Bacon Sub. L. 32, P. 43	E-8-E-7 = 2640.30'	2640'740 Chains	2639.99'
Tientenberg Sub. L. 41, P. 22	E-8-E-9 = 2633.69'	2640'740 Chains	2633.38'
Forcier's Valley View Sub. L. 32, P. 31			
S/P of Forcier's Mound Sub. L. 33, P. 47			

C. Description of monument for corner and accessories established to perpetuate locating the position of the corner:

Set a 3/4" Bar with an aluminum cap stamped "Macomb County Monumentation - MI Act 345 #40165" in a new monument box

- AZ 268° 269.94' to centerline top hydrant
- AZ 241° 117.64' to Mag nail w/ remonumentation tag S'y side U. Pole
- AZ 203° 58.32' to Mag nail w/ remonumentation tag W'y side U. Pole
- AZ 150° 96.58' to Mag nail w/ remonumentation tag NE side U. Pole
- AZ 40° 81.18' to Mag nail w/ remonumentation tag NW side U. Pole

1.7' ± W. to W. edge concrete
 20.0' ± S. to CL asphalt at Westfall Dr

The selected location is accepted by me and is generally accepted by Professional Surveyors as the best available evidence of the position of the original corner.

Signed by *Jeffrey A. Wright* Date: 2 DECEMBER 1997
 Surveyor's Michigan License No. 40165

7210