

LAND CORNER RECORDATION CERTIFICATE  
 Filing Requirement of Act 74, Mich. P.A. 1970

For corners in  
Macomb  
 (County)

Located In:	Corner Code #
Shelby Twp.	E-11
T 3N. R 12E.	
T _____ R _____	
T _____ R _____	
T _____ R _____	
T _____ R _____	
S _____ T _____ R _____	
S _____ T _____ R _____	
S _____ T _____ R _____	
S _____ T _____ R _____	

SURVEY &  
 REMONUMENTATION

APR 07 1998

SECTION

Register of Deeds Stamp & File Number

1. Public Land Survey


2. Property Controlling  
 in Section

3. Miscellaneous  
 Property in Sec.

4. Lot No. \_\_\_\_\_, Recorded Plat \_\_\_\_\_  
 5. Private Claims \_\_\_\_\_

I, Jeffrey A. Wright, in a field survey on May 9, 19 97 do hereby state that under requirements of P.A. 74, Michigan P.A. of 1970, the corner points mentioned in lines 1 and 2 above were in conformance with regulations and rules therefore as required in the current manual of survey instructions of the United States Department of the Interior, Bureau of Land Management or by a decree of a Court of Law and/or that the corner points mentioned in lines 3, 4 and 5 above were in conformance with the rules of the Michigan Board of Land Surveyors or by a Decree of a Court of Law; established, re-established, monumented, recovered, found as expressed below:

NOTE: Not more than 2 corners, all in the same town and range, may be recorded on this certificate.

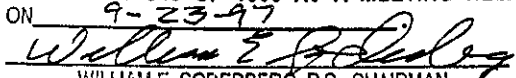ACCEPTED BY THE MACOMB COUNTY SURVEY PEER  
 GROUP AS THE OFFICIAL CORNER UNDER MICHIGAN  
 PUBLIC ACT 345 OF 1990 AT A MEETING HELD  
 ON 9-23-97  
  
 WILLIAM E. SODERBERG, P.S., CHAIRMAN

	A	B	C	D	E	F	G	H	I	J	K	L
1												
2	6	5	4	3	2	1						
3												
4	7	8	9	10	11	12						
5												
6	18	17	16	15	14	13						
7												
8	19	20	21	22	23	24						
9												
10	30	29	28	27	26	25						
11												
12	31	32	33	34	35	36						
13												

A. Description of original monument and accessories and/or subsequent restoration:

Date	Surveyor	Number	Type	L.	P.	Monument Box
1817	Wampler		Set Post	GLO Records		No


B. Description of corner evidence found and/or method applied in restoring or reestablishing corner:

No monumentation found  
 Corner established by monumentation in Parkdale Subdivision L. 31, P.15  
 Corner does not fit location established by Sherlock's Parkdale Sub. #1 L. 59, P. 17

Location supported by corners in:	Ground	GLO	Grid
Sherlock's Parkdale Sub. #1 L. 59, P. 17	E-11-E-10=2971.62'	2640/40 Chains	2971.51'
Auburndale Sub. L. 20, P.46	E-11-E-12=2635.17'	2640/40 Chains	2634.86'

C. Description of monument for corner and accessories established to perpetuate locating the position of the corner:

Set Concrete Monument with an aluminum cap stamped "Macomb County Monument - MI Act 345 of 1990"  
 AZ 300° 23.93' to Mag nail w/ remonumentation tag NE side 8" Oak  
 AZ 35° 34.75' to Mag nail w/ remonumentation tag SE side 13" Elm  
 AZ 85° 34.21' to Mag nail w/ remonumentation tag S'ly side 16" Ash  
 AZ 185° 22.11' to Mag nail w/ remonumentation tag W. side 7" Hickory  
 77' ± N. to S. edge of water (Clinton River)

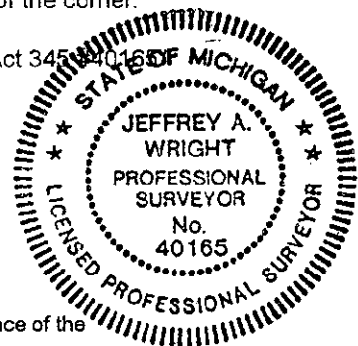

The selected location is accepted by me and is generally accepted by Professional Surveyors as the best available evidence of the position of the original corner.

Signed by Jeffrey A. Wright Date: 2 DECEMBER 1997  
 Surveyor's Michigan License No. 40165