

**LAND CORNER RECORDATION CERTIFICATE**  
 Filing Requirement of Act 74, Mich. P.A. 1970

For corners in

Macomb (County)	Located In:	Corner Code #
	Shelby Twp.	
1. Public Land Survey	T <u>3N.</u> R <u>12E.</u>	<u>E-12</u>
	T _____ R _____	_____
	T _____ R _____	_____
	T _____ R _____	_____
2. Property Controlling in Section	S _____ T _____ R _____	_____
	S _____ T _____ R _____	_____
3. Miscellaneous Property in Sec.	S _____ T _____ R _____	_____
	S _____ T _____ R _____	_____

**SURVEY &  
 REMONUMENTATION**

APR 07 1998

SECTION

Register of Deeds Stamp & File Number

4. Lot No. \_\_\_\_\_, Recorded Plat \_\_\_\_\_  
 5. Private Claims \_\_\_\_\_

I, Jeffrey A. Wright, in a field survey on May 9, 19 97 do hereby state that under requirements of P.A. 74, Michigan P.A. of 1970, the corner points mentioned in lines 1 and 2 above were in conformance with regulations and rules therefore as required in the current manual of survey instructions of the United States Department of the Interior, Bureau of Land Management or by a decree of a Court of Law and/or that the corner points mentioned in lines 3, 4 and 5 above were in conformance with the rules of the Michigan Board of Land Surveyors or by a Decree of a Court of Law; established, re-established, monumented, recovered, found as expressed below:

**NOTE: Not more than 2 corners, all in the same town and range, may be recorded on this certificate.**

1	A	B	C	D	E	F	G	H	I	J	K	L
2		6		5		4		3		2		1
3												
4		7		8		9		10		11		12
5												
6		18		17		16		15		14		13
7												
8		19		20		21		22		23		24
9												
10		30		29		28		27		26		25
11												
12		31		32		33		34		35		36
13												

A. Description of original monument and accessories and/or subsequent restoration:

Date	Surveyor	Number	Type	L.	P.	Monument Box
1817	Wampler		Set Post	GLO Records		No
1978	Hagan	9206	S. T-iron	2939	889	No

B. Description of corner evidence found and/or method applied in restoring or reestablishing corner:

Found T-iron on extension of Mound Road

Location supported by corners in:  
 Eyster's Clinton River Gardens Sub. L. 7, P. 8-9  
 Carolyn Clinton Corners L. 39, P. 44  
 S/P of Eyster's Mound Road Farms #4 L. 20, P. 24

ACCEPTED BY THE MACOMB COUNTY SURVEY PEER GROUP AS THE OFFICIAL CORNER UNDER MICHIGAN PUBLIC ACT 345 OF 1990 AT A MEETING HELD ON 9-23-97.


*William E. Soderberg*  
 WILLIAM E. SODERBERG, P.S., CHAIRMAN

Fits call in:  
 ULC Job #871037-370 Ground E-12-E-11 = 2635.17' GLO 2640'140 Chains Grid 2634.86'  
 ULC Job #94504-2659 Unable to establish distance to E-13 2640'140 Chains  
 ULC Job #910433-2080 (Due to M-59 Construction)

C. Description of monument for corner and accessories established to perpetuate locating the position of the corner:

Replaced T-iron with a 3/4" Bar with an aluminum cap stamped "Macomb County Monument M.L.A. 345 #40165"

- AZ 71° 57.88' to Mag nail with remonumentation tag NW side U. Pole
- AZ 136° 164.23' to centerline top hydrant
- AZ 219° 68.81' to Mag nail with remonumentation tag NW side U. Pole
- AZ 351° 163.12' to Mag nail with remonumentation tag E'ly side U. Pole
- AZ 295° 193.28' to Mag nail with remonumentation tag NW side 12" Spruce

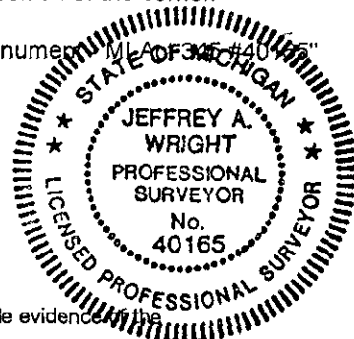

The selected location is accepted by me and is generally accepted by Professional Surveyors as the best available evidence of the position of the original corner.

Signed by *Jeffrey A. Wright* Date: 2 DECEMBER 1997  
 Surveyor's Michigan License No. 40165