

**LAND CORNER RECORDATION CERTIFICATE**  
 Filing Requirement of Act 74, Mich. P.A. 1970

For corners in

Macomb (County)	Located In: Shelby Twp.	Corner Code #
1. Public Land Survey	T 3N. R 12E.	F-7
	T R	
	T R	
	T R	
2. Property Controlling in Section	S T R	
	S T R	
3. Miscellaneous Property in Sec.	S T R	
	S T R	

**SURVEY &  
 REMONUMENTATION**

**APR 07 1998**

**SECTION**

Register of Deeds Stamp & File Number

4. Lot No. \_\_\_\_\_, Recorded Plat \_\_\_\_\_  
 5. Private Claims \_\_\_\_\_

I, Jeffrey A. Wright, in a field survey on May 9, 19 97 do hereby state that under requirements of P.A. 74, Michigan P.A. of 1970, the corner points mentioned in lines 1 and 2 above were in conformance with regulations and rules therefore as required in the current manual of survey instructions of the United States Department of the Interior, Bureau of Land Management or by a decree of a Court of Law and/or that the corner points mentioned in lines 3, 4 and 5 above were in conformance with the rules of the Michigan Board of Land Surveyors or by a Decree of a Court of Law; established, re-established, monumented, recovered, found as expressed below:

**NOTE: Not more than 2 corners, all in the same town and range, may be recorded on this certificate.**

1	A	B	C	D	E	F	G	H	I	J	K	L
2	6	5	4	3	2	1						
3												
4	7	8	9	10	11	12						
5												
6	18	17	16	15	14	13						
7												
8	19	20	21	22	23	24						
9												
10	30	29	28	27	26	25						
11												
12	31	32	33	34	35	36						
13												

A. Description of original monument and accessories and/or subsequent restoration:

Date	Surveyor	Number	Type	L.	P.	Monument Box
1817	Wampler		Set Post	GLO Records		No
1986	Avey	30076	F. 5/8" Bar	3945	711	No

B. Description of corner evidence found and/or method applied in restoring or reestablishing corner:

Found	Ground	GLO	Grid
Found 1" Pipe 4.8' (+/-) S. of S. edge of concrete pavement	F-7-E-7 = 2660.02'	2640/40 Chains	2659.70'
Location supported by corners in: Adjacent properties	F-7-G-7 = 2647.06'	2640/40 Chains	2646.75'

Fits call in:  
 ULC Job #86123-2575


ACCEPTED BY THE MACOMB COUNTY SURVEY PEER GROUP AS THE OFFICIAL CORNER UNDER MICHIGAN PUBLIC ACT 345 OF 1990 AT A MEETING HELD ON 9-23-97

William E. Soderberg  
 WILLIAM E. SODERBERG, P.S., CHAIRMAN

C. Description of monument for corner and accessories established to perpetuate locating the position of the corner:

Replaced 1" Pipe with 3/4" Bar with an aluminum cap stamped "Macomb County Monumentation - MI 40165" in new monument box

- AZ 86° 339.43' to centerline top hydrant
- AZ 100° 61.14' to Mag nail with remonumentation tag N. side U. Pole
- AZ 287° 171.45' to centerline top hydrant
- AZ 269° 134.68' to Mag nail with remonumentation tag N. side U. Pole
- AZ 318° 71.95' to PK nail with remonumentation tag SW side U. Pole
- AZ 65° 112.36' to PK nail with remonumentation tag NW side U. Pole

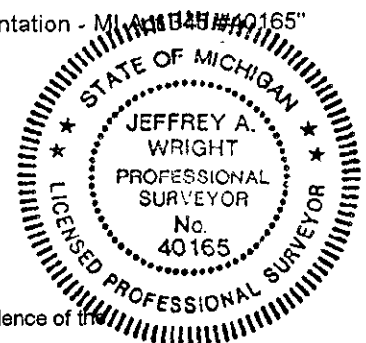

The selected location is accepted by me and is generally accepted by Professional Surveyors as the best available evidence of the position of the original corner.

Signed by Jeffrey A. Wright  
 Surveyor's Michigan License No. 40165

Date: 2 DECEMBER 1997