

LAND CORNER RECORDATION CERTIFICATE
 Filing Requirement of Act 74, Mich. P.A. 1970

SURVEY &
 REMONUMENTATION

APR 07 1998

SECTION

For corners in	Located In:	Corner Code #
Macomb (County)	Shelby Twp.	
1. Public Land Survey	T 3N. R 12E.	F-11
	T _____ R _____	_____
	T _____ R _____	_____
	T _____ R _____	_____
2. Property Controlling in Section	S _____ T _____ R _____	_____
	S _____ T _____ R _____	_____
3. Miscellaneous Property in Sec.	S _____ T _____ R _____	_____
	S _____ T _____ R _____	_____

Register of Deeds Stamp & File Number

4. Lot No. _____, Recorded Plat _____
 5. Private Claims _____

I, Jeffrey A. Wright, in a field survey on May 9, 19 97 do hereby state that under requirements of P.A. 74, Michigan P.A. of 1970, the corner points mentioned in lines 1 and 2 above were in conformance with regulations and rules therefore as required in the current manual of survey instructions of the United States Department of the Interior, Bureau of Land Management or by a decree of a Court of Law and/or that the corner points mentioned in lines 3, 4 and 5 above were in conformance with the rules of the Michigan Board of Land Surveyors or by a Decree of a Court of Law, established, re-established, monumented, recovered, found as expressed below:

NOTE: Not more than 2 corners, all in the same town and range, may be recorded on this certificate.

	A	B	C	D	E	F	G	H	I	J	K	L
1												
2	6		5		4		3		2		1	
3												
4	7		8		9		10		11		12	
5												
6	18		17		16		15		14		13	
7												
8	19		20		21		22		23		24	
9												
10	30		29		28		27		26		25	
11												
12	31		32		33		34		35		36	
13												

A. Description of original monument and accessories and/or subsequent restoration:

Date	Surveyor	Number	Type	L.	P.	Monument Box
1817	Wampler		Set Post	GLO Records		No

ACCEPTED BY THE MACOMB COUNTY SURVEY PEER GROUP AS THE OFFICIAL CORNER UNDER MICHIGAN PUBLIC ACT 345 OF 1990 AT A MEETING HELD 9-23-97

William E. Soderberg
 WILLIAM E. SODERBERG, P.S., CHAIRMAN

B. Description of corner evidence found and/or method applied in restoring or reestablishing corner:

F. 1/2" Bar


Location supported by corners in:
 Lincoln Meadows L. 56, P. 28-29
 S/P Church's Sub. L. 21, P. 2

Ground	GLO	Grid
F-11 - E-11 = 2578.94'	2640/140 chains	2578.64'
F-11 - G-11 = 2674.03'	2640/140 chains	2673.72'

C. Description of monument for corner and accessories established to perpetuate locating the position of the corner:

Replaced 1/2" Bar with concrete monument with an aluminum cap stamped "Macomb County Monument MI Act 345 #40165"

AZ 273° 101.23' to Mag nail with remonumentation tag N. side 10" Ash
 AZ 244° 117.81' to Mag nail with remonumentation tag NW side Multi 24" Maple
 AZ 94° 71.76' to Mag nail with remonumentation tag N. side 14" Wild Cherry
 AZ 275° 567.76' to Mag nail with remonumentation tag in RR tie

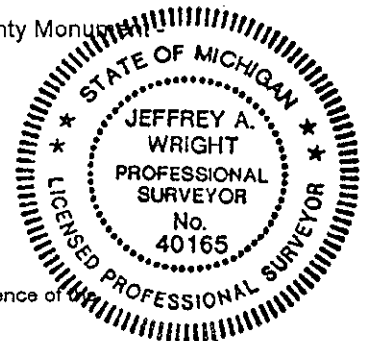

The selected location is accepted by me and is generally accepted by Professional Surveyors as the best available evidence of position of the original corner.

Signed by [Signature]

Date: 2 DECEMBER 1997

Surveyor's Michigan License No. 40165