

SURVEY & REMONUMENTATION

APR 28 1995

C0158307 LIBER:06543 PAGE:329 08:35A 01/05/1995
 CARMELLA SABAUGH-MACOMB COUNTY, MI REG/DEEDS

COMMISSION

LAND CORNER RECORDATION CERTIFICATE
Filing Requirement of Act 74, Mich. P.A. 1970


For corners in

<u>Macomb</u> (County)	Located In:	<u>Shelby</u> Twp.	Corner Code \neq
1. Public Land Survey	T <u>3N.R</u>	<u>12E.</u>	<u>G-6</u>
	T _____	_____	_____
	T _____	_____	_____
	T _____	_____	_____
2. Property Controlling in Section	S _____	T _____	R _____
	S _____	T _____	R _____
3. Miscellaneous Property in Sec.	S _____	T _____	R _____
	S _____	T _____	R _____
4. Lot No. _____, Recorded Plat _____			
5. Private Claims _____			

Register of Deeds Stamp & File Number

I, Warren C. Avey, in a field survey on September 16, 19 94, do hereby certify that under requirements of P.A. 74, Michigan P.A. of 1970, the corner points mentioned in lines 1 and 2 above were in conformance with regulations and rules therefore as required in the current manual of survey instructions of the United States Department of the Interior, Bureau of Land Management or by a decree of a Court of Law and/or that the corner points mentioned in lines 3, 4 and 5 above were in conformance with the rules of the Michigan Board of Land Surveyors or by a Decree of a Court of Law; established, re-established, monumented, re-monumented, recovered, found as expressed below:

NOTE: Not more than 4 corners, all in the same town and range, may be recorded on this certificate.

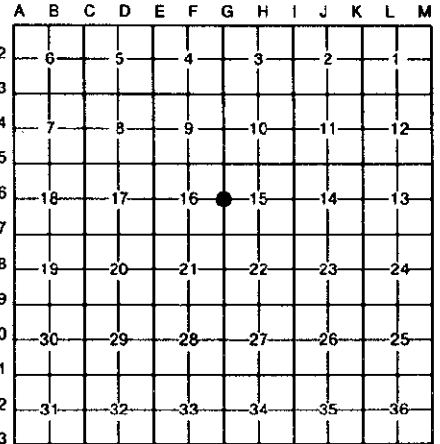

A. Description of original monument and accessories and/or subsequent restoration:

Date	What	L.	P.	Who	Surveyor's ID	Corner Type	Mon. Box
1817	GLO			Wampler	N/A	Post	No
1979	LCRC	3218	58	Soderberg	17635	PK nail	No

B. Description of corner evidence found and/or method applied in restoring or reestablishing corner:

Found PK nail in Asphalt
 Fits L. 3218 P. 58 AZ 18° 117.58' PK nail E. face U. Pole
 AZ 344° 101.55' PK nail E. face U. Pole

ACCEPTED BY THE MACOMB COUNTY SURVEY PEER GROUP AS THE OFFICIAL CORNER UNDER MICHIGAN PUBLIC ACT 345 OF 1990 AT A MEETING HELD ON 9-27-94
William E. Soderberg
 WILLIAM E. SODERBERG, P.S., CHAIRMAN

Location supported by corners in:	Bellarine Sub.,	L.44, P.42	G-6 - G-5 = 2641.32'
	Bellarine Manor Sub.,	L.50, P.47	G-6 - G-7 = 2639.69'
	S/P of Smiley's Southfield Acres	L.22, P.35	
	S/P of Disco	L.17, P.12	

C. Description of monument for corner and accessories established to perpetuate locating the position of the corner:

Replaced PK nail with 3/4" Bar w/ Alum. cap stamped "Macomb County Monument - MI. ACT 345" 30076 in new Monument Box
 AZ 92° 31.62' to set PK nail in MCW tag N. face U. Pole
 AZ 246° 39.98' to set PK nail in MCW tag Nly. face U. Pole
 AZ 339° 101.63' to set PK nail in MCW tag S.W. face U. Pole
 AZ 13° 117.99' to set PK nail in MCW tag N.W. face U. Pole

The selected location is accepted by me and is generally accepted by Professional Surveyor's as the best available evidence of the position of the original corner.

Signed by Warren C. Avey
 Surveyor's Michigan License No. 30076

