

# SURVEY & REMONUMENTATION

C0158310 LIBER:06543 PAGE:332 08:35A 01/05/1995  
APR 28 1995 CARMELLA SABAUGH-MACOMB COUNTY, MI REG/DEEDS

## COMMISSION

### LAND CORNER RECORDATION CERTIFICATE Filing Requirement of Act 74, Mich. P.A. 1970

For corners in

Macomb <small>(County)</small>	Located In: Shelby Twp.	Corner Code =#
1. Public Land Survey	T <u>3N.</u> R <u>12E.</u>	<u>G-10</u>
	T _____ R _____	_____
	T _____ R _____	_____
	T _____ R _____	_____
2. Property Controlling in Section	S _____ T _____ R _____	_____
	S _____ T _____ R _____	_____
3. Miscellaneous Property in Sec.	S _____ T _____ R _____	_____
	S _____ T _____ R _____	_____
4. Lot No. _____, Recorded Plat _____		
5. Private Claims _____		

Register of Deeds Stamp & File Number

I, Warren C. Avey, in a field survey on September 16, 19 94, do hereby certify that under requirements of P.A. 74, Michigan P.A. of 1970, the corner points mentioned in lines 1 and 2 above were in conformance with regulations and rules therefore as required in the current manual of survey instructions of the United States Department of the Interior, Bureau of Land Management or by a decree of a Court of Law and/or that the corner points mentioned in lines 3, 4 and 5 above were in conformance with the rules of the Michigan Board of Land Surveyors or by a Decree of a Court of Law; established, re-established, monumented, re-monumented, recovered, found as expressed below:

	A	B	C	D	E	F	G	H	I	J	K	L	M
2	6		5		4		3		2		1		
3													
4	7		8		9		10		11		12		
5													
6	18		17		16		15		14		13		
7													
8	19		20		21		22		23		24		
9													
10	30		29		28		27		26		25		
11													
12	31		32		33		34		35		36		
13													

**NOTE: Not more than 4 corners, all in the same town and range, may be recorded on this certificate.**

A. Description of original monument and accessories and/or subsequent restoration:

Date	What	L.	P.	Who	Surveyor's ID	Corner Type	Mon. Box
1817	GLO			Wampler	N/A	Post	No

B. Description of corner evidence found and/or method applied in restoring or reestablishing corner:

Found 1/2" Bar in Mon. Box in Asphalt (Bar is cemented into Mon. Box)

Location supported by corners in: S/P Burton VanDyke Gardens	L.16, P.12	G-10 - G09 = 2646.78'
S/P of Wallace	L.18, P.41	G-10 - G-11 = 2649.23'
S/P of Rhondas Little Farms No. 1	L.22, P.30	
Greenview Subdivision	L.59, P.3	

ACCEPTED BY THE MACOMB COUNTY SURVEY PEER GROUP AS THE OFFICIAL CORNER UNDER MICHIGAN PUBLIC ACT 345 OF 1990 AT A MEETING HELD ON 9-27-94

*William E. Soderberg*  
WILLIAM E. SODERBERG, P.S., CHAIRMAN


C. Description of monument for corner and accessories established to perpetuate locating the position of the corner:

Set Alum Cap stamped "Macomb County Monument - MI. ACT 345" 30076 on 1/2" Bar in existing Mon. Box

- AZ 314° 45.83' to PK nail in S.W. face Util. Pole
- AZ 149° 81.94' to set PK nail in MCW tag in S.W. face Util. Pole
- AZ 166° 171.70' to centerline stem of Fire Hydrant
- AZ 193° 150.25' to set PK nail in MCW tag in S.E. face Util. Pole

The selected location is accepted by me and is generally accepted by Professional Surveyor's as the best available evidence of the position of the original corner.

Signed by Warren C. Avey  
Surveyor's Michigan License No. 30076

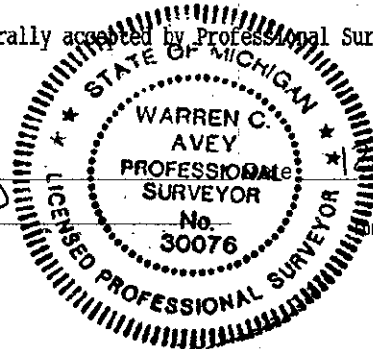

- 1 - 94