

# SURVEY & REMONUMENTATION

APR 28 1995 C0158311 LIBER:06543 PAGE:333 08:35A 01/05/1995  
 CARMELLA SABAUGH-MACOMB COUNTY, MI REG/DEEDS

## COMMISSION LAND CORNER RECORDATION CERTIFICATE Filing Requirement of Act 74, Mich. P.A. 1970

For corners in

<u>Macomb</u> (County)	Located In: <u>Shelby</u> <u>Twp.</u>	Corner Code <u>≠</u>
1. Public Land Survey	T <u>3N.R</u> <u>12E.</u>	<u>H-5</u>
	T _____ R _____	_____
	T _____ R _____	_____
	T _____ R _____	_____
2. Property Controlling in Section	S _____ T _____ R _____	_____
	S _____ T _____ R _____	_____
3. Miscellaneous Property in Sec.	S _____ T _____ R _____	_____
	S _____ T _____ R _____	_____
4. Lot No. _____, Recorded Plat _____		
5. Private Claims _____		

Register of Deeds Stamp & File Number

I, Warren C. Avey, in a field survey on September 16, 19 94, do hereby certify that under requirements of P.A. 74, Michigan P.A. of 1970, the corner points mentioned in lines 1 and 2 above were in conformance with regulations and rules therefore as required in the current manual of survey instructions of the United States Department of the Interior, Bureau of Land Management or by a decree of a Court of Law and/or that the corner points mentioned in lines 3, 4 and 5 above were in conformance with the rules of the Michigan Board of Land Surveyors or by a Decree of a Court of Law; established, re-established, monumented, re-monumented, recovered, found as expressed below:

A	B	C	D	E	F	G	H	I	J	K	L	M
2	6	5	4	3	2	1						
3												
4	7	8	9	10	11	12						
5												
6	18	17	16	15	14	13						
7												
8	19	20	21	22	23	24						
9												
10	30	29	28	27	26	25						
11												
12	31	32	33	34	35	36						
13												

**NOTE: Not more than 4 corners, all in the same town and range, may be recorded on this certificate.**

A. Description of original monument and accessories and/or subsequent restoration:

Date	What	L.	P.	Who	Surveyor's ID	Corner Type	Mon. Box
1817	GLO			Wampler	N/A	Post	No
1978	LCRC	3055	822	Avendt	16034	Iron	No
1979	LCRC	3168	264	Fenn	23505	3/8" Bar	No
1980	LCRC	3252	335	Kobs	14097	1/2" Bar	No

B. Description of corner evidence found and/or method applied in restoring or reestablishing corner:

Found 1/2" Bar in Monument Box 2' S. of S. edge of Asphalt Road

Fits L. 3055 P. 822 S.50°E. 35.46' PK nail in P. Pole  
 N.45°E. 86.52' Spike in P. Pole  
 Fits L. 3168 P. 264 N.E. 86.48' nail in DE Pole  
 S.E. 35.43' nail in DE Pole  
 Fits L. 3252 P. 335 W.SW. 90.46' PK nail in U. Pole  
 E.NE. 86.50' nail in U. Pole  
 S.E. 35.43' nail in U. Pole

H-5 - I-5 = 2648.76'  
 H-5 - G-5 = 2642.02'

Location supported by corners in: S/P of Disco, L.17, P.12  
 Wolf Est., L.43, P.23

ACCEPTED BY THE MACOMB COUNTY SURVEY PEER GROUP AS THE OFFICIAL CORNER UNDER MICHIGAN PUBLIC ACT 345 OF 1990 AT A MEETING HELD ON 9-27-94  
*William E. Soderberg*  
 WILLIAM E. SODERBERG, P.S., CHAIRMAN


C. Description of monument for corner and accessories established to perpetuate locating the position of the corner:

Replaced 1/2" Bar with 3/4" Bar w/ Alum. cap stamped "Macomb County Monument - MI. ACT 345" 30076 in existing Monument Box

AZ 124° 35.39' to PK nail in MCRC Disk in S.W. face U. Pole  
 AZ 257° 90.46' to PK nail in MCRC Disk in S.W. face U. Pole  
 AZ 290° 104.96' to PK nail in S.W. face U. Pole  
 AZ 66° 86.54' to form nail in RLS Disk

The selected location is accepted by me and is generally accepted by other professional surveyor's as the best available evidence of the position by the original corner.

Signed by *Warren C. Avey*  
 Surveyor's Michigan License No. 30076

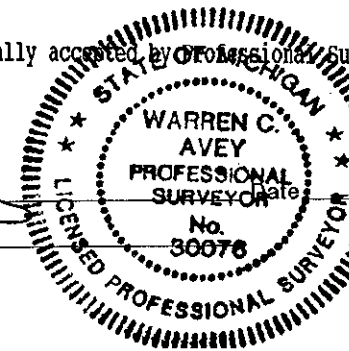

2-1-94