

FEB 27 1997

COMMISSION

LAND CORNER RECORDATION CERTIFICATE  
Filing Requirement of Act 74, Mich. P.A. 1970

For corners in

| Macomb<br>(County)                    | Located In:<br>Shelby Twp. | Corner Code # |
|---------------------------------------|----------------------------|---------------|
| 1. Public Land Survey                 | T 3N. R 12E.               | H-9           |
|                                       | T _____ R _____            | _____         |
|                                       | T _____ R _____            | _____         |
|                                       | T _____ R _____            | _____         |
| 2. Property Controlling<br>in Section | S _____ T _____ R _____    | _____         |
|                                       | S _____ T _____ R _____    | _____         |
| 3. Miscellaneous<br>Property in Sec.  | S _____ T _____ R _____    | _____         |
|                                       | S _____ T _____ R _____    | _____         |

Register of Deeds Stamp & File Number

4. Lot No. \_\_\_\_\_, Recorded Plat \_\_\_\_\_  
5. Private Claims \_\_\_\_\_

I, Jeffrey A. Wright, in a field survey on June 20, 19 96 do hereby state that under requirements of P.A. 74, Michigan P.A. of 1970, the corner points mentioned in lines 1 and 2 above were in conformance with regulations and rules therefore as required in the current manual of survey instructions of the United States Department of the Interior, Bureau of Land Management or by a decree of a Court of Law and/or that the corner points mentioned in lines 3, 4 and 5 above were in conformance with the rules of the Michigan Board of Land Surveyors or by a Decree of a Court of Law, established, re-established, monumented, recovered, found as expressed below:

**NOTE: Not more than 2 corners, all in the same town and range, may be recorded on this certificate.**

ACCEPTED BY THE MACOMB COUNTY SURVEY BOARD  
GROUP AS THE OFFICIAL CORNER UNDER MICHIGAN  
PUBLIC ACT 345 OF 1990 AT A MEETING HELD  
ON 7-25-96

*William E. Soderberg*  
WILLIAM E. SODERBERG, P.S., CHAIRMAN

|    | A  | B | C  | D | E  | F | G  | H | I  | J | K | L  | M |
|----|----|---|----|---|----|---|----|---|----|---|---|----|---|
| 1  |    |   |    |   |    |   |    |   |    |   |   |    |   |
| 2  | 6  |   | 5  |   | 4  |   | 3  |   | 2  |   |   | 1  |   |
| 3  |    |   |    |   |    |   |    |   |    |   |   |    |   |
| 4  | 7  |   | 8  |   | 9  |   | 10 |   | 11 |   |   | 12 |   |
| 5  |    |   |    |   |    |   |    |   |    |   |   |    |   |
| 6  | 18 |   | 17 |   | 16 |   | 15 |   | 14 |   |   | 13 |   |
| 7  |    |   |    |   |    |   |    |   |    |   |   |    |   |
| 8  | 19 |   | 20 |   | 21 |   | 22 |   | 23 |   |   | 24 |   |
| 9  |    |   |    |   |    |   |    |   |    |   |   |    |   |
| 10 | 30 |   | 29 |   | 28 |   | 27 |   | 26 |   |   | 25 |   |
| 11 |    |   |    |   |    |   |    |   |    |   |   |    |   |
| 12 | 31 |   | 32 |   | 33 |   | 34 |   | 35 |   |   | 36 |   |
| 13 |    |   |    |   |    |   |    |   |    |   |   |    |   |

A. Description of original monument and accessories and/or subsequent restoration:

| Date | Surveyor | Number | Type         | L.          | P.  | Monument Box |
|------|----------|--------|--------------|-------------|-----|--------------|
| 1817 | Wampler  |        | Set Post     | GLO Records |     | No           |
| 1968 | MCRC     |        | F. 1/2" Bar  | Unrecorded  |     | No           |
| 1972 | Avey     | 15396  | F. 1/2" Pipe | 2351        | 334 | No           |
| 1973 | Avey     | 15396  | F. 1/2" Pipe | Unrecorded  |     | No           |
| 1978 | Avey     | 15396  | F. 1/2" Pipe | Unrecorded  |     | No           |
| 1978 | Kobs     | 14097  | F. 1/2" Pipe | 3021        | 210 | No           |
| 1990 | Avey     | 15396  | F. 1/2" Pipe | Unrecorded  |     | No           |
| 1991 | Avey     | 30076  | F. 1/2" Pipe | 5063        | 825 | No           |
| 1996 | Wright   | 40165  | F. 1/2" Pipe | Unrecorded  |     | No           |

B. Description of corner evidence found and/or method applied in restoring or reestablishing corner:

F. 1/2" Pipe in centerline asphalt road

Fits call in:

L. 2351, P. 334 F. 1/2" Pipe  
L. 3021, P. 210 F. 1/2" Pipe  
L. 5063, P. 825 F. 1/2" Pipe

Location supported by corners in:

Munro-Van Dyke Farms L. 19, P. 5  
Forest Lake Sub L. 89, P. 18-23  
Shelby Woods Sub L. 78, P. 16-17  
Shelby Woods Sub #2 L. 78, P. 18-19

H-9 - G-9 = 2638.21'  
H-9 - I-9 = 2661.98'

GLO


2640' / 40 chains  
2640' / 40 chains

C0438547 LIBER:07245 PAGE:408 08:59A 11/14/1996  
CARMELLA SABAUGH-MACOMB COUNTY, MI REG/DEEDS

C. Description of monument for corner and accessories established to perpetuate locating the position of the corner:

Replaced 1/2" pipe w/ 3/4" Bar in new monument box w/ aluminum cap stamped - "Macomb County Monument, MI Act 345 #40165"

AZ 286° 111.94' to Mag nail with remonumentation tag SW side U. Pole  
AZ 29° 38.62' to Mag nail with remonumentation tag SE side U. Pole  
AZ 71° 114.30' to Mag nail with remonumentation tag N'y side U. Pole  
AZ 191° 68.93' to Mag nail with remonumentation tag E'y side 14" W. Cherry  
AZ 204° 67.06' to Mag nail with remonumentation tag SE corner of a 4 x 4 wood fence post

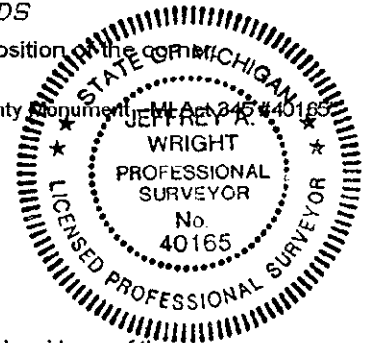

The selected location is accepted by me and is generally accepted by Professional Surveyor's as the best available evidence of the position by the original corner.

Signed by *Jeffrey A. Wright* Date: 16 OCTOBER 1996

Surveyor's Michigan License No. 40165

572