

LAND CORNER RECORDATION CERTIFICATE
Filing Requirement of Act 74, Mich. P.A. 1970

B997882

For corners in

<u>MACOMB</u> <small>(County)</small>	Located In:	Corner Code ##
	SHELBY TWP.	
1. Public Land Survey	T <u>3N</u> R <u>12E</u>	<u>H-13</u>
	T _____ R _____	_____
	T _____ R _____	_____
	T _____ R _____	_____
2. Property Controlling in Section	S _____ T _____ R _____	_____
	S _____ T _____ R _____	_____
3. Miscellaneous Property in Sec.	S _____ T _____ R _____	_____
	S _____ T _____ R _____	_____
4. Lot No. _____, Recorded Plat _____		
5. Private Claims _____		

LIBER 06161 PG 232

Register of Deeds Stamp & File Number

I, BRUCE ANTCLIFF, in a field survey on NOVEMBER 22, 19 93, do hereby certify that under requirements of P.A. 74, Michigan P.A. of 1970, the corner points mentioned in lines 1 and 2 above were in conformance with regulations and rules therefore as required in the current manual of survey instructions of the United States Department of the Interior, Bureau of Land Management or by a decree of a Court of Law and/or that the corner points mentioned in lines 3, 4 and 5 above were in conformance with the rules of the Michigan Board of Land Surveyors or by a Decree of a Court of Law; established, re-established, monumented, re-monumented, recovered, found as expressed below:

	A	B	C	D	E	F	G	H	I	J	K	L	M
2	6	5	4	3	2	1							
3													
4	7	8	9	10	11	12							
5													
6	18	17	16	15	14	13							
7													
8	19	20	21	22	23	24							
9													
10	30	29	28	27	26	25							
11													
12	31	32	33	34	35	36							
13													

NOTE: Not more than 4 corners, all in the same town and range, may be recorded on this certificate.

A. Description of original monument and accessories and/or subsequent restoration:

GLO-Post, (AS H13,3N,12E) NO WITS. REMAIN

MDOT (1963) - PK NAIL W/BRASS CAP
 TEL. POLE, NORTH, 58.78'
 16" POPLAR, S02E, 78.20'
 CONC. MON, S40E, 78.88'


MDOT (1988) & LCRC (1988) L4507,P849, -3/4" BOLT W/1" HEAD IN MON BOX
 MDOT N&T IN 15" THORNAPPLE, N20E, 72.17'
 "+" IN NE BOLT OF CONC. BASE OF LIGHT, S30E, 72.65'
 "+" IN NE BOLT OF CONC. BASE OF LIGHT, S70W, 82.91'
 "+" IN SE COR IN CONCRETE BASE OF STEEL POST, N40W, 83.90'

ALL RECORDS INDICATE THAT THIS CORNER IS COMMON TO BOTH T2N,R12E & T3N,R12E.

B. Description of corner evidence found and/or method applied in restoring or reestablishing corner:
 FOUND 3/4" BOLT W/1" HEAD IN MON BOX

93 DEC 22 AM 9:04
 CARMELLA SABAUGH
 REGISTER OF DEEDS
 MACOMB COUNTY, MI

ACCEPTED BY THE MACOMB COUNTY SURVEY PEER GROUP AS THE OFFICIAL CORNER UNDER MICHIGAN PUBLIC ACT 345 1990 AT A MEETING HELD ON 12-1-93
Frank J. Dedecker
 FRANK J. DEDecker, P.S., PE, CHAIRMAN

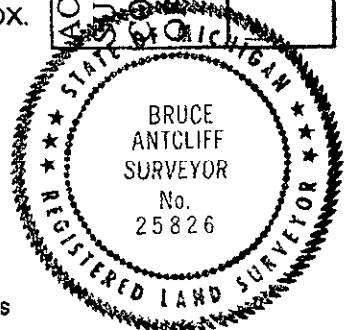

C. Description of monument for corner and accessories established to perpetuate locating the position of
 SET MACOMB COUNTY REMONUMENTATION MARKER AND CAP #25826 IN EXIST. MON. BOX.
 WITNESSES

FND PK NAIL W/BRASS CAP, N05E, 59.56
 FND "+" IN NE BOLT OF CON BASE OF LIGHT, S70W, 83.02
 FND "+" IN NE BOLT OF CON BASE OF LIGHT, S29E, 72.68
 SET "+" IN SW BOLT OF CON BASE OF LIGHT, N65E, 66.83

The selected location is accepted by me and is generally accepted by Professional Surveyors as the best available evidence of the position of the original corner.

Signed by Bruce Antcliff Date 12-9-93

Surveyor's Michigan License No. 25826