

LAND CORNER RECORDATION CERTIFICATE
Filing Requirement of Act 74, Mich. P.A. 1970

For corners in

<u>Macomb</u> (County)	Located in: Shelby Twp.	Corner Code #
1. Public Land Survey	T <u>3N.</u> R <u>12E.</u>	<u>I-10</u>
	T _____ R _____	_____
	T _____ R _____	_____
	T _____ R _____	_____
2. Property Controlling in Section	S _____ T _____ R _____	_____
	S _____ T _____ R _____	_____
3. Miscellaneous Property in Sec.	S _____ T _____ R _____	_____
	S _____ T _____ R _____	_____

**SURVEY &
REMONUMENTATION**

FEB 27 1997

COMMISSION

Register of Deeds Stamp & File Number

4. Lot No. _____, Recorded Plat _____
 5. Private Claims _____

1	A	B	C	D	E	F	G	H	I	J	K	L	M
2		6		5		4		3		2		1	
3													
4		7		8		9		10		11		12	
5													
6		18		17		16		15		14		13	
7													
8		19		20		21		22		23		24	
9													
10		30		29		28		27		26		25	
11													
12		31		32		33		34		35		36	
13													

I, Jeffrey A. Wright, in a field survey on June 20, 1996 do hereby state that under requirements of P.A. 74, Michigan P.A. of 1970, the corner points mentioned in lines 1 and 2 above were in conformance with regulations and rules therefore as required in the current manual of survey instructions of the United States Department of the Interior, Bureau of Land Management or by a decree of a Court of Law and/or that the corner points mentioned in lines 3, 4 and 5 above were in conformance with the rules of the Michigan Board of Land Surveyors or by a Decree of a Court of Law; established, re-established, monumented, recovered, found as expressed below:

NOTE: Not more than 2 corners, all in the same town and range, may be recorded on this certificate.

ACCEPTED BY THE MACOMB COUNTY SURVEY PEER
 GROUP AS THE OFFICIAL CORNER UNDER MICHIGAN
 PUBLIC ACT 345 OF 1990 AT A MEETING HELD
 ON 7-23-96

William E. Soderberg
 WILLIAM E. SODERBERG, P.S., CHAIRMAN

A. Description of original monument and accessories and/or subsequent restoration:

Date	Surveyor	Number	Type	L.	P.	Monument Box
1817	Wampler		Set Post	GLO Records		No
1972	Avey	15396	F. Monument	2351	330	No
1987	Erickson	16929	F. 3/4" Bar	4328	565	No
1991	Avey	30076	F. 3/4" Bar	5063	827	No

C0438550 LIBER:07245 PAGE:411 08:59A 11/14/1996
 CARMELLA SABAUGH-MACOMB COUNTY, MI REG/DEEDS

B. Description of corner evidence found and/or method applied in restoring or reestablishing corner:


F. 3/4" Bar 0.5' +/- E. of M-53 R/W fence

Fits call in:	Location supported by corners in:		
L. 4328, P. 565	F. 3/4" Bar	S/P of Burton-Van Dyke Gardens	L. 16, P. 12
L. 5063, P. 827	F. 3/4" Bar	S/P of Rhoda's Little Farm	L. 22, P. 30
			I-10 - I-11 = 2629.62'
			I-10 - I-9 = 2631.34'
			GLO Records
			2640' / 40 chains
			2640' / 40 chains

C. Description of monument for corner and accessories established to perpetuate locating the position of the corner:

Replaced 3/4" Bar w/ 3/4" Bar w/ aluminum cap stamped "Macomb County Monument - MI Act 345 #40165"

- AZ 228° 25.28' to Mag nail with remonumentation tag N'y side 6" Ash
- AZ 276° 27.40' to Mag nail with remonumentation tag S'y side 8" Ash
- AZ 293° 49.37' to Mag nail with remonumentation tag N'y side 10" Ash
- AZ 258° 83.01' to Mag nail with remonumentation tag in asphalt shoulder at station 742 + 30 +/- (N.B. M-53)
- AZ 275° 92.55' to station 750 + 00 (N.B. M-53)
- AZ 310° 141.19' to station 751 + 00 (N.B. M-53)
- AZ 207° 128.62' to station 749 + 00 (N.B. M-53)

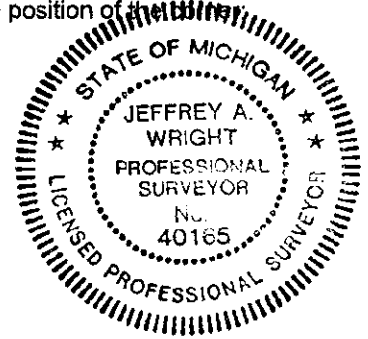

The selected location is accepted by me and is generally accepted by Professional Surveyors as the best available evidence of the position by the original corner.

Signed by *Jeffrey A. Wright* Date: 16 OCTOBER 1996
 Surveyor's Michigan License No. 40165

575