LIBER 06166 PG 080 B999693

RECORDED IN MACOMB COUNTY
RECORDING AT: 8:30 A M.
DEC 28 1993
CLERK - REGISTER OF DEEDS
MACOMB COUNTY, MICHIGAN

Register of Deeds Stamp & File Number

LAND CORNER RECORDATION CERTIFICATE

Filing Requirement of Act 74, Mich. P.A. 1970

For corners in MACOMB (County) Located In: SHELBY TOWNSHIP Corner Code #

1. Public Land Survey T-3-N R-12-E M-2
   T ____ R ____
   T ____ R ____
   T ____ R ____
2. Property Controlling S ____ T ____ R ____
   in Section S ____ T ____ R ____
3. Miscellaneous S ____ T ____ R ____
   Property in Sec. S ____ T ____ R ____

4. Lot No. _____ , Recorded Plat _____
5. Private Claims _____

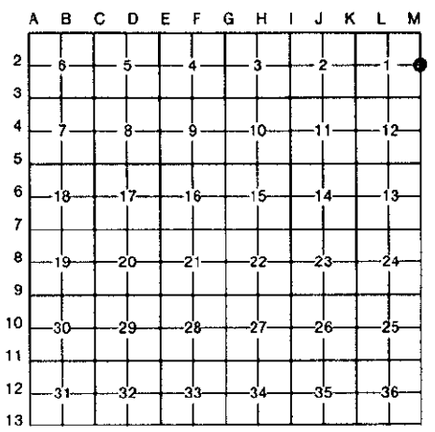

I, DAVID PAWLACZYK in a field survey on NOVEMBER 24, 19 93, do hereby certify that under requirements of P.A. 74, Michigan P.A. of 1970, the corner points mentioned in lines 1 and 2 above were in conformance with regulations and rules therefore as required in the current manual of survey instructions of the United States Department of the Interior, Bureau of Land Management or by a decree of a Court of Law and/or that the corner points mentioned in lines 3, 4 and 5 above were in conformance with the rules of the Michigan Board of Land Surveyors or by a Decree of a Court of Law; established, re-established, monumented, re-monumented, recovered, found as expressed below:

NOTE: Not more than 4 corners, all in the same town and range, may be recorded on this certificate.

A. Description of original monument and accessories and/or subsequent restoration:

POST WAS SET PER GOVERNMENT LAND OFFICE RECORDS
S. 75° E. 15 LINKS 36" WHITE OAK
N. 15° E. 13 LINKS 26" WHITE OAK

ACCEPTED BY THE MACOMB COUNTY SURVEY PEER GROUP AS THE OFFICIAL CORNER UNDER MICHIGAN PUBLIC ACT 345 OF 1990 AT A MEETING HELD ON 12-15-93
FRANK J. DeDECKER, PS, PE, CHAIRMAN

B. Description of corner evidence found and/or method applied in restoring or reestablishing corner:

FOUND A 1/2" RE-ROD IN GRAVEL ROAD PREVIOUSLY LOCATED BY THE MACOMB COUN ROAD COMMISSION (UNDATED).

C. Description of monument for corner and accessories established to perpetuate locating the position of the corner:

REPLACED THE 1/2" RE-ROD WITH P.A. 345 ALUMINUM CAP STAMPED #17632 ON 3/4" X 24" IRON ROD.
ACCESSORIES ESTABLISHED

N. 85° W. 72.71 WITNESS TAG IN UTILITY POLE
N. 20° E. 46.59 WITNESS TAG IN UTILITY POLE
N. 80° E. 129.64 S.W. HOUSE CORNER
S. 30° E. 131.07 WITNESS TAG IN UTIL

Signed by _____ Date 12-24-93

Surveyor's Michigan License No. 17632

STATE OF MICHIGAN DAVID PAWLACZYK LAND SURVEYOR NO. 17632 REGISTERED LAND

FORM APPROVED BY MICHIGAN STATE BOARD OF LAND SURVEYORS: JAN. 28, 1971 REVISED MAY 14, 1976 REVISED JAN. 1983