

LAND CORNER RECORDATION CERTIFICATE
Filing Requirement of Act 74, Mich. P.A. 1970

For corners in

		SHELBY TOWNSHIP	
<u>MACOMB</u>	Located in:	Corner Code #	
(County)			
1. Public Land Survey	<u>T 3N R 12E</u>	<u>M4</u>	
	T <u> </u> R <u> </u>	<u> </u>	
	T <u> </u> R <u> </u>	<u> </u>	
	T <u> </u> R <u> </u>	<u> </u>	
2. Property Controlling in Section	S <u> </u> T <u> </u> R <u> </u>	<u> </u>	
	S <u> </u> T <u> </u> R <u> </u>	<u> </u>	
3. Miscellaneous Property in Sec.	S <u> </u> T <u> </u> R <u> </u>	<u> </u>	
	S <u> </u> T <u> </u> R <u> </u>	<u> </u>	

1164
 LIBER 9275 PAGE 515
 01/04/2000 09:29:18 A.M.
 MACOMB COUNTY, MI
 CARMELLA SABAUGH, REG/DEEDS

Register of Deeds Stamp & File Number

4. Lot No. _____, Recorded Plat _____
 5. Private Claims _____

I, CRAIG P. AMEY, in a field survey on AUGUST 14, 19 99
 do hereby certify that under requirements of P.A. 74, Michigan P.A. of 1970, the corner points mentioned in lines 1 and 2 above were in conformance with regulations and rules therefore as required in the current manual of survey instructions of the United States Department of the Interior, Bureau of Land Management or by a decree of a Court of Law and for that the corner points mentioned in lines 3, 4 and 5 above were in conformance with the rules of the Michigan Board of Land Surveyors or by a Decree of a Court of Law; established, re-established, monumented, re-monumented, recovered, found as expressed below:

	A	B	C	D	E	F	G	H	I	J	K	L	M
1													
2	6	5	4	3	2	1							
3													
4	7	8	9	10	11	12							
5													
6	18	17	16	15	14	13							
7													
8	19	20	21	22	23	24							
9													
10	30	29	28	27	26	25							
11													
12	31	32	33	34	35	36							
13													

NOTE: Not more than 4 corners, all in the same town and range, may be recorded on this certificate.

A. Description of original monument and accessories and/or subsequent restoration:

- | | | | |
|---------|----------------------|---------------------|--|
| A. 1817 | GLO | J. WAMPLER | SET POST |
| B. 1978 | LCRC, L. 3021 P. 208 | H. KOB'S #14097 | FOUND 1/2" IRON BAR |
| C. 1988 | LCRC, L. 4479 P. 89 | J. FENN #23505 | FOUND 1/2" IRON BAR. |
| D. 1993 | LCRC, L. 6166 P. 82 | D. PAWLACZYK #17632 | SET 3/4" IRON WITH REMON. CAP IN MONUMENT BOX. |
| E. 1995 | LCRC, L. 6832 P. 280 | J. WRIGHT # 40165 | FOUND REMONUMENTATION MARKER IN MONUMENT BOX |

B. Description of corner evidence found and/or method applied in restoring or reestablishing corner:

FOUND 3/4" IRON IN MONUMENT BOX 1.0' BELOW GRAVEL SURFACE IN THE CENTER OF HAYES ROAD

75° 119.04' SOUTHWEST CORNER OF BLOCK PUMP HOUSE (D. 118.98, E. 118.95)
 185° 132.00' WEST QUARTER CORNER SECTION 7 MACOMB TOWNSHIP (D. 132.00)

THE CORNER AGREES WITH WITNESSES IN THE LCRC APPROVED BY THE MACOMB COUNTY REMONUMENTATION PEER GROUP. ADDITIONAL WITNESSES WERE SET PRIOR TO THE RECONSTRUCTION OF HAYES ROAD. THE CORNER WAS RESET AND REWITNESSED AFTER THE CONSTRUCTION WAS COMPLETED.

DISTANCES TO ADJACENT REMONUMENTATION CORNERS


- M4 - M3 2696.99' (GLO 40.00ch, 2640.00')
 M4 - M5 2705.50' (GLO 40.00ch, 2640.00')
 M4 - A4 (T3N,R13E) 132.02'

C. Description of monument for corner and accessories established to perpetuate locating the position of the corner:

SET 3/4" IRON IN MONUMENT BOX WITH ALUMINUM MACOMB COUNTY REMONUMENTATION CAP #34970

- | | | |
|------|---------|---|
| 75° | 119.08' | SOUTHWEST CORNER OF BLOCK PUMP HOUSE |
| 110° | 27.96' | FOUND PK IN THE SOUTH FACE OF A UTILITY POLE) |
| 270° | 60.06' | FOUND MONUMENT |
| 270° | 30.17' | SET MAG NAIL WITH TAG #30092 IN THE NORTHEAST FACE OF A GUY POLE |
| 210° | 122.87' | FOUND MAG NAIL WITH TAG #30092 IN THE EAST FACE OF A UTILITY POLE |

THE SELECTED LOCATION IS ACCEPTED BY ME AND IS GENERALLY ACCEPTED BY PROFESSIONAL SURVEYORS AS THE BEST AVAILABLE EVIDENCE OF THE POSITION OF THE ORIGINAL CORNER SET BY THE MACOMB COUNTY SURVEY PEER GROUP AS THE OFFICIAL CORNER UNDER MICHIGAN ACT 345 OF 1990 AT A MEETING HELD

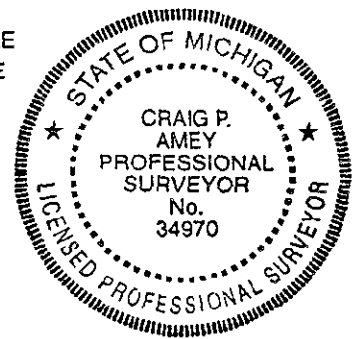

William E. Soderberg
 WILLIAM E. SODERBERG, P.S., CHAIRMAN

Signed by *Craig P. Amey* Date 12/28/99
 Surveyor's Michigan License No. 34970

976