

LAND CORNER RECORDATION CERTIFICATE
Filing Requirement of Act 74, Mich. P.A. 1970

1091842
 LIBER 9268 PAGE 30
 12/27/1999 01:15:42 P.M.
 MACOMB COUNTY, MI
 CARMELLA SABAUGH, REG/DEEDS

For corners in <u>Macomb</u> (County)	Located In: <u>Shelby Twp.</u>	Corner Code #
1. Public Land Survey	T _____ R _____ T _____ R _____ T _____ R _____ T _____ R _____	<u>#006</u>
2. Property Controlling in Section	S <u>5</u> T <u>3N.</u> R <u>12E</u> S <u>8</u> T <u>3N.</u> R <u>12E.</u>	<u>Centerline int. @ 25 Mile Rd. &</u>
3. Miscellaneous Property in Sec.	S _____ T _____ R _____ S _____ T _____ R _____	<u>Shelby Rd.</u>

Register of Deeds Stamp & File Number

4. Lot No. _____, Recorded Plat _____
 5. Private Claims _____

I, Jeffrey A. Wright, in a field survey on 24 August, 19 99 do hereby state that under requirements of P.A. 74, Michigan P.A. of 1970, the corner points mentioned in lines 1 and 2 above were in conformance with regulations and rules therefore as required in the current manual of survey instructions of the United States Department of the Interior, Bureau of Land Management or by a decree of a Court of Law and/or that the corner points mentioned in lines 3, 4 and 5 above were in conformance with the rules of the Michigan Board of Land Surveyors or by a Decree of a Court of Law; established, re-established, monumented, recovered, found as expressed below:

NOTE: Not more than 2 corners, all in the same town and range, may be recorded on this certificate.

1	A	B	C	D	E	F	G	H	I	J	K	L	M
2		6		5		4		3		2		1	
3													
4		7		8		9		10		11		12	
5													
6		18		17		16		15		14		13	
7													
8		19		20		21		22		23		24	
9													
10		30		29		28		27		26		25	
11													
12		31		32		33		34		35		36	
13													

A. Description of original monument and accessories and/or subsequent restoration:

Date	Surveyor	Number	Type	L.	P.	Monument Box
No Original Monument Set						
1995	Wright	40165	Set PK nail Act 132	Unrecorded		No
1995	Wright	40165	Set PK nail Act 74	6832	272	No

B. Description of corner evidence found and/or method applied in restoring or reestablishing corner:

This (Jeffrey A. Wright) surveyor was contacted by the M.C.R.C. when the intersection was being redone (1997) to put the point in the correct location instead of the 1/2" bar w/monument box that is 0.65' NW +/-

Found 1/2" bar in monument box, as previously recorded.
 (Located at the int. of 25 Mile Rd. & Shelby Rd.)
 Location supported by corners in:

Mount Vernon Sub. #1 L. 44, P. 50


Ground Distances:
 to C-3 = 1348.02' m.
 to D-3 = 1361.64' m.

BY THE MACOMB COUNTY SURVEYOR PEER
 AS THE OFFICIAL CORNER UNDER MICHIGAN
 PUBLIC ACT 345 OF 1990 AT A MEETING HELD
 ON 9/28/99
William E. Soderberg
 WILLIAM E. SODERBERG, P.S., CHAIRMAN

C. Description of monument for corner and accessories established to perpetuate locating the position of the corner:

Replaced 1/2" bar in existing monument box w/3/4" bar with an aluminum cap stamped "Macomb County Monument -Mi Act 345 #40165" in said monument box. (Corner is on Section Line)

(AZ. 45°) 64.39' to Mag nail w/Macomb County Witness Tag NW side U. pole
 (AZ. 292°) 76.35' to Mag nail w/Macomb County Witness Tag N. side 76" oak
 (AZ. 219°) 69.29' to Mag nail w/Macomb County Witness Tag SE side U. pole
 (AZ. 135°) 71.63' to Mag nail w/Macomb County Witness Tag SW side U. pole

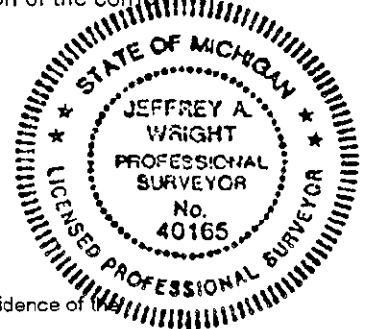

The selected location is accepted by me and is generally accepted by Professional Surveyors as the best available evidence of position of the original corner.

Signed by *Jeffrey A. Wright*
 Surveyor's Michigan License No. 40165

Date: 9 DECEMBER 1999