


SURVEY &  
REMONUMENTATION

NOV 06 1998

SECTION

Macomb Township T3N, R13E

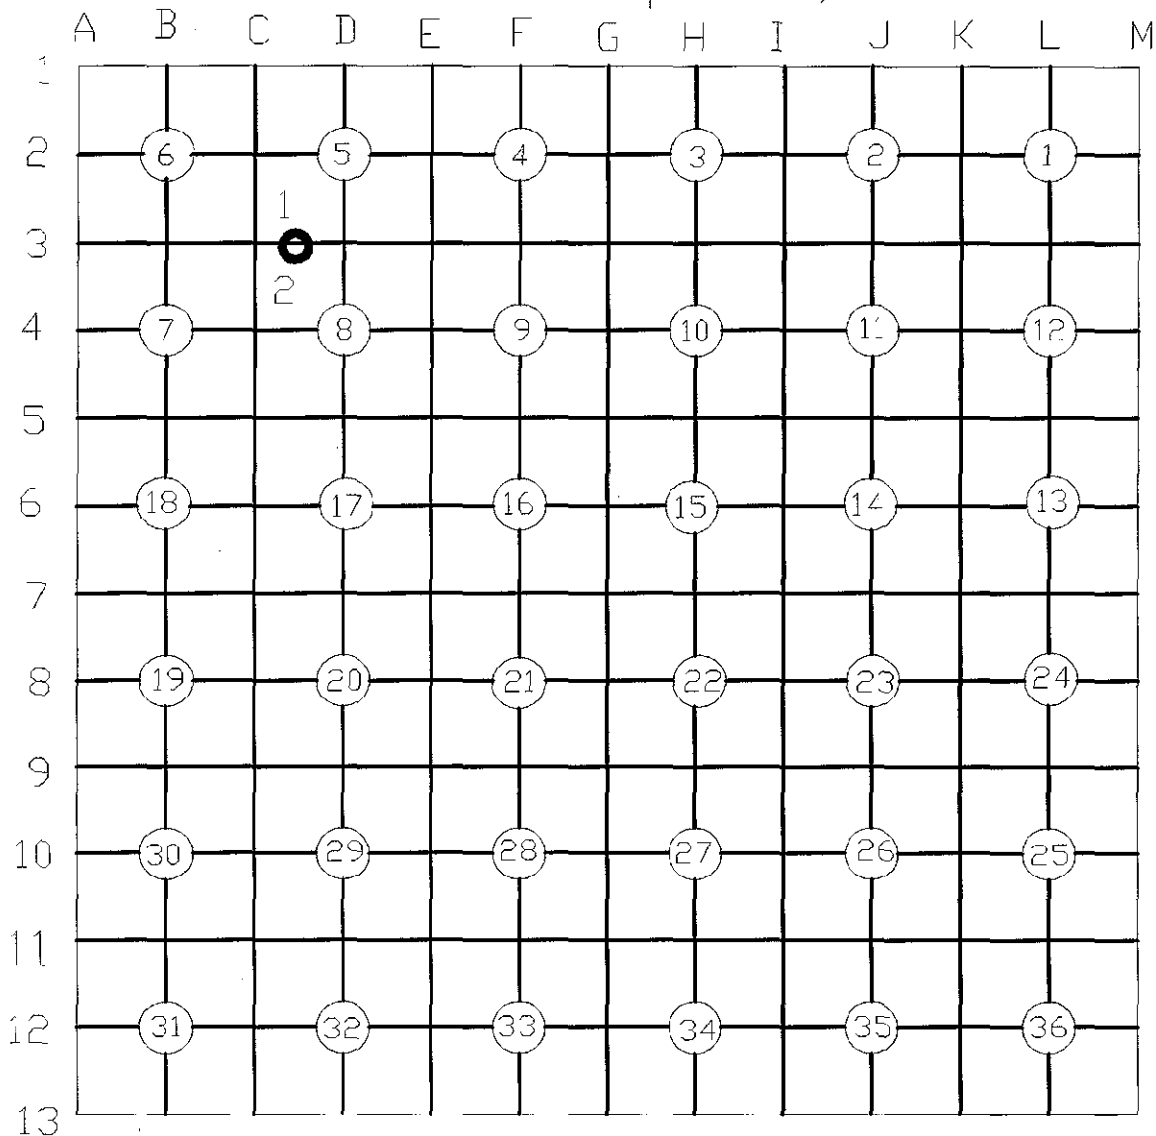

1 = BETWEEN C-3 AND D-3 L6523 P 904 #805

2 = SAME POINT ADD INFORMATION L 6595 P 59 #806