

MAR 17 2000

LAND CORNER RECORDATION CERTIFICATE
Filing Requirement of Act 74, Mich. P.A. 1970

For corners in SECTION

MACOMB (County) Located In: MACOMB TOWNSHIP Corner Code #
1. Public Land Survey T 3N R 13E A3
2. Property Controlling in Section S T R
3. Miscellaneous Property in Sec. S T R

1167 LIBER 9275 PAGE 518 01/04/2000 09:29:18 A.M. MACOMB COUNTY, MI CARMELLA SABAUGH, REG/DEEDS

Register of Deeds Stamp & File Number

4. Lot No. , Recorded Plat
5. Private Claims

Grid table with columns A-M and rows 1-13. A dot is marked at row 3, column B.

I, CRAIG P. AMEY, in a field survey on AUGUST 14, 19 99 do hereby certify that under requirements of P.A. 74, Michigan P.A. of 1970, the corner points mentioned in lines 1 and 2 above were in conformance with regulations and rules therefore as required in the current manual of survey instructions of the United States Department of the Interior, Bureau of Land Management or by a decree of a Court of Law and for that the corner points mentioned in lines 3, 4 and 5 above were in conformance with the rules of the Michigan Board of Land Surveyors or by a Decree of a Court of Law; established, re-established, monumented, re-monumented, recovered, found as expressed below:

NOTE: Not more than 4 corners, all in the same town and range, may be recorded on this certificate.

ACCEPTED BY THE MACOMB COUNTY SURVEY PEER GROUP AS THE OFFICIAL CORNER UNDER MICHIGAN PUBLIC ACT 345 OF 1990 AT A MEETING HELD ON 12/22/99 WILLIAM E. SODERSERG, P.S., CHAIRMAN

A. Description of original monument and accessories and/or subsequent restoration:

- A. 1817 GLO W. PRESTON SET POST
B. 1993 LCRC, L. 5957, P. 04 D. LITTLE #31596 FOUND 1" IRON ROD
C. 1993 LCRC, L. 6166, P. 70 D. PAWLACZYK #17632 SET 3/4" IRON WITH REMON. CAP IN MONUMENT BOX.
D. 1995 LCRC, L. 6946 P. 764 J. WRIGHT #40165 FOUND REMON. MARKER IN MONUMENT BOX

B. Description of corner evidence found and/or method applied in restoring or reestablishing corner:

FOUND 3/4" IRON IN MONUMENT BOX 1.0' BELOW GRAVEL SURFACE IN THE CENTER OF HAYES ROAD

5° 157.22' NORTHEAST CORNER OF SECTION 12, SHELBY TOWNSHIP (T3N, R12E) (C. 157.28)
80° 95.25' FOUND PK WITH MACOMB COUNTY WITNESS TAG IN THE SOUTH SIDE OF A UTILITY POLE (C. 95.34, D. 95.22)

THE CORNER AGREES WITH WITNESSES IN THE LCRC APPROVED BY THE MACOMB COUNTY REMONUMENTATION PEER GROUP AND A SUBSEQUENT LCRC BY J. WRIGHT. ADDITIONAL WITNESSES WERE SET PRIOR TO RECONSTRUCTION OF HAYES ROAD. THE CORNER WAS RESET AND REWITNESSED AFTER THE CONSTRUCTION WAS COMPLETED.

DISTANCES TO ADJACENT REMONUMENTATION CORNERS

A3 - A2 2646.78' A3 - A4 2671.40' A3 - B3 1953.27' (GLO 39.30ch, 1933.80') A3 - M3 (T3N, R12E) 157.31 (GLO 1.48lks, 0.98')


C. Description of monument for corner and accessories established to perpetuate locating the position of the corner:

SET 3/4" IRON IN MONUMENT BOX WITH ALUMINUM MACOMB COUNTY REMONUMENTATION CAP #34970

- 80° 95.25' FOUND PK WITH MACOMB COUNTY WITNESS TAG IN THE SOUTH SIDE OF A UTILITY POLE
150° 77.98' SET PK WITH TAG # 30092 IN THE SOUTHWEST FACE OF A UTILITY POLE
235° 86.80' FOUND PK WITH MACOMB COUNTY WITNESS TAG IN THE SOUTHEAST FACE OF A UTILITY POLE
300° 71.93' FOUND PK WITH MACOMB COUNTY WITNESS TAG IN THE SOUTH FACE OF A UTILITY POLE

THE SELECTED LOCATION IS ACCEPTED BY ME AND IS GENERALLY ACCEPTED BY PROFESSIONAL SURVEYORS AS THE BEST AVAILABLE EVIDENCE OF THE POSITION OF THE ORIGINAL CORNER

Signed by [Signature] Date 12/22/99
Surveyor's Michigan License No. 34970

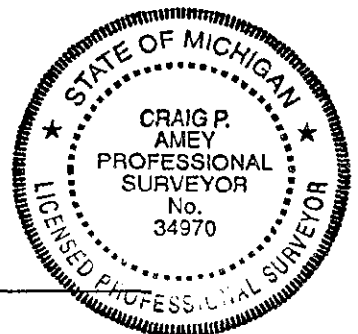

952