

LAND CORNER RECORDATION CERTIFICATE
Filing Requirement of Act 74, Mich. P.A. 1970

B997896

For corners in

MACOMB

(County)

Located In:

Corner Code #

MACOMB TWP

- | | | |
|---------------------------------------|--------------------------|--------------------|
| 1. Public Land Survey | T <u>3N</u> R <u>13E</u> | <u>A-13</u> |
| | T _____ R _____ | _____ |
| | T _____ R _____ | _____ |
| | T _____ R _____ | _____ |
| 2. Property Controlling in Section | S _____ T _____ R _____ | <u>Sec. # 1 pm</u> |
| | S _____ T _____ R _____ | _____ |
| 3. Miscellaneous Property in Sec. | S _____ T _____ R _____ | _____ |
| | S _____ T _____ R _____ | _____ |
| 4. Lot No. _____, Recorded Plat _____ | | |
| 5. Private Claims _____ | | |

LIBER **06161** PG **246**

Register of Deeds Stamp & File Number

I, BRUCE ANTCLIFF in a field survey on NOVEMBER 22, 19 93

do hereby certify that under requirements of P.A. 74, Michigan P.A. of 1970, the corner points mentioned in lines 1 and 2 above were in conformance with regulations and rules therefore as required in the current manual of survey instructions of the United States Department of the Interior, Bureau of Land Management or by a decree of a Court of Law and/or that the corner points mentioned in lines 3, 4 and 5 above were in conformance with the rules of the Michigan Board of Land Surveyors or by a Decree of a Court of Law; established, re-established, monumented, re-monumented, recovered, found as expressed below:

NOTE: Not more than 4 corners, all in the same town and range, may be recorded on this certificate.

	A	B	C	D	E	F	G	H	I	J	K	L	M
2	6	5	4	3	2	1							
3													
4	7	8	9	10	11	12							
5													
6	13	17	16	15	14	13							
7													
8	19	20	21	22	23	24							
9													
10	30	29	28	27	26	25							
11													
12	31	32	33	34	35	36							
13													

A. Description of original monument and accessories and/or subsequent restoration:

GLO-Post, NO WITS. REMAIN
 MCRC (1934) PLACED IRON-NO WITS REMAIN

MDOT & LCRC (1974) L2500,P794-1" IRON/MON BOX
 POWER POLE, N30W, 68.30'
 POWER POLE, S25W, 91.98'
 TEL. POLE, N25E, 61.00'

EDISON FIELD NOTES (1980)-MON BOX
 NAIL IN POLE, N45E, 62.4'
 NAIL IN POLE, N45W, 68.1'
 NAIL IN POLE, S45W, 91.8'

LCRC (1986) L4080,P891-1/2" BAR IN MON BOX
 NW BOLT SIGN POST BASE, SE, 98.66'
 SE BOLT SIGN POST BASE, SW, 108.37'
 MCRC N&T SE FACE GUY POLE, NE, 62.29'
 CONC. NAIL NW FACE UTIL. POLE, NW, 68.23'

LCRC (1987) L4131,P656-ROD IN MON BOX
 N&T IN UTIL. POLE, N05E, 59.47'
 N&T IN UTIL. POLE, N60E, 118.10'
 PK IN UTIL. POLE, S50E, 92.30'

THIS CORNER IS COMMON TO ALL FOUR TOWNSHIPS.

LCRC (1991) L5290,P290-1/2" BARMON BOX
 MDOT N&T SE SIDE PP, WSW, 85.64'
 PK SE SIDE PP, SSW, 86.53'
 PK SW SIDE PP, NW, 96.53'
 PK NW SIDE PP, NE, 91.80'

MDOT (1990)-1/2" IRON IN MON BOX
 MDOT N&T IN GUY POLE, N30E, 62.40'
 MDOT N&T IN GUY POLE, N30W, 68.35'
 NE BOLT SIGN BASE, S40E, 99.58'
 MDOT N&T IN PP, S60W, 85.54'

B. Description of corner evidence found and/or method applied in restoring or reestablishing corner:
 FOUND 1/2" BAR/MON. BOX

FOUND AND VERIFIED ONE OF THE ABOVE WITNESSES

93 DEC 22 AM 9: 05

CARMELLA SABAUGH
 REGISTER OF DEEDS
 MACOMB COUNTY, MI


**ACCEPTED BY THE MACOMB COUNTY
 SURVEY PEER GROUP AS THE OFFICIAL
 CORNER UNDER MICHIGAN PUBLIC ACT 345
 OF 1990 AT A MEETING HELD ON
 12-1-93**

Frank J. DeDecker
FRANK J. DODECKER, PS, PE, CHAIRMAN

C. Description of monument for corner and accessories established to perpetuate locating the position of the corner:

SET MACOMB COUNTY REMONUMENTATION MARKER AND CAP #25826 IN EXIST. MON. BOX.
 WITNESSES

- FND NE BOLT SIGN BASE, S47E, 99.57'
- SET N&T - PK & MC TAG IN SE FACE P POLE, S57W, 85.85'
- SET N&T - PK & MC TAG IN SW FACE P POLE, N44W, 83.59'
- SET N&T - PK & MC TAG IN N FACE P POLE, S68E, 149.67'

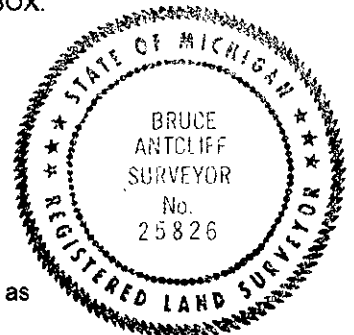

The selected location is accepted by me and is generally accepted by Professional Surveyors as the best available evidence of the position of the original corner.

Signed by Bruce Antcliff

Date 12-9-93

Surveyor's Michigan License No. 25826