

# SURVEY & REMONUMENTATION

APR 28 1995

C150759

## COMMISSION

## LAND CORNER RECORDATION CERTIFICATE

Filing Requirement of Act 74, Mich. P.A. 1970

For corners in Macomb

Macomb Twp.

94 DEC -9 PM 2:47

CARMELO LARAUGH  
REGISTER OF DEEDS  
MACOMB COUNTY, MI

LIBER 6523 PAGE 906

Register of Deeds Stamp & File Number

	Located In:		Corner Code #
	3N	13E	
1. Public Land Survey	T	R	B-7
	T	R	
	T	R	
	T	R	
2. Property Controlling in Section	S	T	R
	S	T	R
3. Miscellaneous Property in Sec.	S	T	R
	S	T	R

4. Lot No. \_\_\_\_\_, Recorded Plat \_\_\_\_\_  
5. Private Claims \_\_\_\_\_

Robert D. Kohn

August 15

94

I, \_\_\_\_\_, in a field survey on \_\_\_\_\_, 19 \_\_\_\_\_, do hereby certify that under requirements of P.A. 74, Michigan P.A. of 1970, the corner points mentioned in lines 1 and 2 above were in conformance with regulations and rules therefore as required in the current manual of survey instructions of the United States Department of the Interior, Bureau of Land Management or by a decree of a Court of Law and/or that the corner points mentioned in lines 3, 4 and 5 above were in conformance with the rules of the Michigan Board of Land Surveyors or by a Decree of a Court of Law; established, re-established, monumented, re-monumented, recovered, found as expressed below:

**NOTE: Not more than 4 corners, all in the same town and range, may be recorded on this certificate.**

	A	B	C	D	E	F	G	H	I	J	K	L	M
2	6	5	4	3	2	1							
3													
4	7	8	9	10	11	12							
5													
6	18	17	16	15	14	13							
7													
8	19	20	21	22	23	24							
9													
10	30	29	28	27	26	25							
11													
12	31	32	33	34	35	36							
13													

A. Description of original monument and accessories and/or subsequent restoration:

	Notes	W. Preston	N/A	Notes
1817 Post	L.C.R.C.	G. Avendt	#16034	L3242 P632
1980 R.R. spike	L.C.R.C.	W. Soderberg	#17635	L3293 P823
1980 3/4" Square bar	Survey	W. Soderberg	#17635	L3293 P826
1980 1/2" Square bar	Condo.	G. Dely	#05234	L4828 P300
1990 -	L.C.R.C.	R. Donnelly	#21563	L4799 P509
1990 3/4" Iron bar	M.C.R.C.	N/A	N/A	Sec. 18 File 90
N/A 1/2" Iron				

B. Description of corner evidence found and/or method applied in restoring or reestablishing corner:

A railroad spike in asphalt pavement still marks this corner. The following witness ties were used to recover and verify its position:

2 ties from L.C.R.C.	L2424 P632
1 tie from L.C.R.C.	L3293 P823
3 ties from L.C.R.C.	L4799 P509

Field measurements were made between the following corners:

B-7 to A-7	2006.94	meas.	1980.00	rec.	G.L.O. Notes
	2007.15	rec.	L4828 P300		Condominium
B-7 to C-7	2658.10	meas.	2640.00		G.L.O. Notes
	2657.84	rec.	L3293 P826		Survey


ACCEPTED BY THE MACOMB COUNTY SURVEY PEER GROUP AS THE OFFICIAL CORNER UNDER MICHIGAN PUBLIC ACT 345 OF 1990 AT A MEETING HELD ON 9-27-94

*William E. Soderberg*  
WILLIAM E. SODERBERG, P.S., CHAIRMAN

C. Description of monument for corner and accessories established to perpetuate locating the position of the corner:

I replaced the R.R. spike with a 3/4" x 24" iron rod with 2" diameter aluminum cap stamped "Macomb County Monument MI Act 345 #26459" in a new monument box.

S.37° E.	145.51'	N.E. corner house #15850
S.74° W.	193.55'	Set P.K. nail and remon. tag N. face U-pole
N.48° W.	189.66'	Centerline top nut fire hydrant
N.75° E.	165.30'	Set P.K. nail and remon. tag N. face U-pole

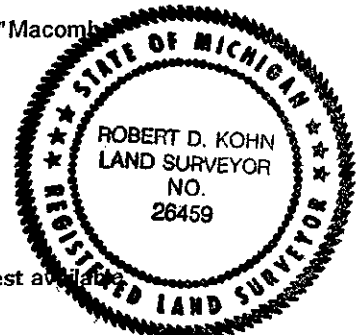

The selected location is accepted by me and generally accepted by Professional Surveyors as the best available evidence of the position of the original corner.

Signed by *Robert D. Kohn*  
Surveyor's Michigan License No. 26459

Date November 9, 1994