

LAND CORNER RECORDATION CERTIFICATE
Filing Requirement of Act 74, Mich. P.A. 1970

For corners in

Macomb Located In: Macomb Twp. Corner Code # _____
 (County)

1. Public Land Survey T 3N R 13E C-1
 T _____ R _____
 T _____ R _____
 T _____ R _____

2. Property Controlling S _____ T _____ R _____
 in Section S _____ T _____ R _____

3. Miscellaneous S _____ T _____ R _____
 Property in Sec. S _____ T _____ R _____

**SURVEY &
 REMONUMENTATION**

FEB 27 1997

COMMISSION

Register of Deeds Stamp & File Number

4. Lot No. _____, Recorded Plat _____

5. Private Claims _____

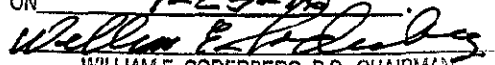
I, Robert D. Kohn, in a field survey on November 30, 1996 do hereby state that under requirements of P.A. 74, Michigan P.A. of 1970, the corner points mentioned in lines 1 and 2 above were in conformance with regulations and rules therefore as required in the current manual of survey instructions of the United States Department of the Interior, Bureau of Land Management or by a decree of a Court of Law and /or that the corner points mentioned in lines 3, 4 and 5 above were in conformance with the rules of the Michigan Board of Land Surveyors or by a Decree of a Court of Law; established, re-established, monumented, recovered, found as expressed below:

NOTE: Not more than 2 corners, all in the same town and range, may be recorded on this certificate.

A	B	C	D	E	F	G	H	I	J	K	L	M
1												
2	6	5	4	3	2	1						
3												
4	7	8	9	10	11	12						
5												
6	18	17	16	15	14	13						
7												
8	19	20	21	22	23	24						
9												
10	30	29	28	27	26	25						
11												
12	31	32	33	34	35	36						
13												

A. Description of original monument and accessories and/or subsequent restoration:

1817 Post	W. Preston	N/A	GLO Notes
1973 1/2" Bar	H. Avey	#15396	L.C.R.C. L2426 P 337
1973 Iron	F. Bridges	#5779	Survey L2420 P327
1973 Iron in mon box	C. Melching	#14767	Survey L2428 P116
1973 1/2" Bar	H. Avey	#15396	Survey L2426 P363
1973 1/2" Bar	H. Avey	#15396	Survey L2496 P754
1984 1/2" iron in mon box	H. Kobs	#14097	L.C.R.C. L3705 P146
1984 1/2" iron in mon box	H. Kobs	#14097	Survey L3795 P109
1985 1/2" iron in mon box	H. Kobs	#14097	Survey L3880 P104
1986 1/2" iron in mon box	H. Kobs	#14097	Survey L4151 P69
1989 1/2" iron in mon box	H. Kobs	#14097	Survey L4866 P819
1992 1/2" iron in mon box	D. King	#30085	Survey L5831 P246
1992 N/A	G. James	#19835	Survey L5625 P260

ACCEPTED BY THE MACOMB COUNTY SURVEY PER GROUP AS THE OFFICIAL CORNER UNDER MICHIGAN PUBLIC ACT 345 OF 1990 AT A MEETING HELD ON 7-23-96

 WILLIAM E. SODERBERG, P.S., CHAIRMAN

B. Description of corner evidence found and/or method applied in restoring or reestablishing corner:

A 1/2" iron rod in a monument box in asphalt pavement currently occupies this corner. The following witness ties were used to recover and verify its position:

- 1 tie matches witnesses from; L2426 P337, L2426 P363, L2496 P754
- 2 ties match witnesses from; L3705 P146, L3795 P109, L3880 P104, L4866 P819

The position of this monument box falls 1.34' south of the line between the south 1/4 corner of Section 31 (B-13) and the S.E. corner of Section 31 (G-13) Ray Twp.

Field measurements were made between the following corners:

- B-1 to C-1 2690.26' meas. C-1 to D-1 2667.59' meas. C-1 to C-13 61.29' meas.
- 61.38' rec. G.L.O.
- 61.28' rec. Survey L3795 P109

C. Description of monument for corner and accessories established to perpetuate locating the position of the corner:

extended North 1.34' from the existing iron rod and monument box and placed a 2" diameter aluminum cap stamped "Macomb County Mi Act 345 #26459" on a 3/4" x 24" iron rod in a new monument box. Witnesses are as follows:

- S. 60°W., 88.65' To center top nut fire hydrant
- S. 45°W., 45.66' P.K. nail & Mac Co remon. tag in S.E. face U-Pole
- S. 60°E., 63.98' P.K. nail & Mac Co remon. tag in S.W. face U-pole
- Due East 61.29' Mac. Co. remon. cap #26459 in mon box (C-13) Ray Twp.
- Due South 1.34' Found 1/2" iron rod in monument box

The selected location is accepted by me and generally accepted by Professional Surveyors as the best available evidence of the position of the original corner.

Signed by Robert D. Kohn
 Surveyor's Michigan License No. #26459

Date November 30, 1996

