

SURVEY & REMONUMENTATION

APR 28 1995

COMMISSION

LAND CORNER RECORDATION CERTIFICATE Filing Requirement of Act 74, Mich. P.A. 1970

C150764

For corners in Macomb

Macomb Twp.

Located In: Corner Code #

	3N	13E	C-8
1. Public Land Survey	T _____	R _____	_____
	T _____	R _____	_____
	T _____	R _____	_____
	T _____	R _____	_____
2. Property Controlling in Section	S _____	T _____	R _____
	S _____	T _____	R _____
3. Miscellaneous Property in Sec.	S _____	T _____	R _____
	S _____	T _____	R _____

LIBER 6523 PAGE 911

94 DEC -9 PM 2: 47

CAMPBELL BAUGH
REGISTER OF DEEDS
MACOMB COUNTY, MI

Register of Deeds Stamp & File Number

4. Lot No. _____, Recorded Plat _____
5. Private Claims _____

Robert D. Kohn

August 22

94

I, _____, in a field survey on _____, 19 _____, do hereby certify that under requirements of P.A. 74, Michigan P.A. of 1970, the corner points mentioned in lines 1 and 2 above were in conformance with regulations and rules therefore as required in the current manual of survey instructions of the United States Department of the Interior, Bureau of Land Management or by a decree of a Court of Law and/or that the corner points mentioned in lines 3, 4 and 5 above were in conformance with the rules of the Michigan Board of Land Surveyors or by a Decree of a Court of Law; established, re-established, monumented, re-monumented, recovered, found as expressed below:

NOTE: Not more than 4 corners, all in the same town and range, may be recorded on this certificate.

	A	B	C	D	E	F	G	H	I	J	K	L	M
2	6		5		4		3		2		1		
3													
4	7		8		9		10		11		12		
5													
6	18		17		16		15		14		13		
7													
8	19		20		21		22		23		24		
9													
10	30		29		28		27		26		25		
11													
12	31		32		33		34		35		36		
13													

A. Description of original monument and accessories and/or subsequent restoration:

	1817 Post	G.L.O. Survey	W. Preston	W. Soderberg	N/A	Notes
	1980 Re-rod	L.C.R.C.	R. Donnelly	#17635	L3263 P916	
	1990 1/2" Iron rod	L.C.R.C.	W. Avey	#21563	L4799 P508	
	1991 1/2" Bar	L.C.R.C.		#30076	L5063 P828	

B. Description of corner evidence found and/or method applied in restoring or reestablishing corner:

A 1/2" iron on a wire fence line to the east still marks this corner. The following witness ties were used to recover and verify its position:

3 ties from L.C.R.C. L4799 P508
2 ties from L.C.R.C. L5063 P828

Field measurements were made between the following corners:

C-8 to C-7	2662.89	meas.		
	2640	rec.	G.L.O. notes	
	2662.86	rec.	L3263 P916	Survey
C-8 to C-9	2667.69	meas.		
	2640	rec.	G.L.O. notes	

ACCEPTED BY THE MACOMB COUNTY SURVEY PEER GROUP AS THE OFFICIAL CORNER UNDER MICHIGAN PUBLIC ACT 345 OF 1990 AT A MEETING HELD ON 9-27-94.


William E. Soderberg
WILLIAM E. SODERBERG, P.S., CHAIRMAN

C. Description of monument for corner and accessories established to perpetuate locating the position of the corner:

I replaced the 1/2" iron with a 3/4" x 24" iron rod with 2" diameter aluminum cap stamped "Macomb County Monument MI Act 345 #26459".

Due North	58.67'	Gas line marker post (3" diameter)
S.71° W.	77.74'	P.K. nail & remon. tag S.E. face 24" Maple
N.44° E.	24.59'	P.K. and remon. tag. N.W. face 10" Ash
Due South	8.65'	P.K. and remon. tag W. face 8" Oak

The selected location is accepted by me and generally accepted by Professional Surveyors as the best available evidence of the position of the original corner.

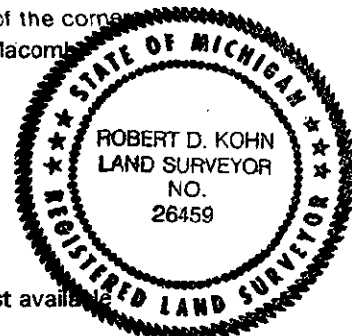

Signed by *Robert D. Kohn* 26459

Date NOVEMBER 9, 1994

Surveyor's Michigan License No. _____