

LAND CORNER RECORDATION CERTIFICATE  
Filing Requirement of Act 74, Mich. P.A. 1970

For corners in WAR 17 2000

MACOMB (County) SECTION

Located in: MACOMB TWP.  
T 3N R 13E Corner Code # C-11

1. Public Land Survey  
T R  
T R  
T R

2. Property Controlling in Section S T R  
S T R

3. Miscellaneous Property in Sec. S T R  
S T R

4. Lot No. \_\_\_\_\_, Recorded Plat \_\_\_\_\_


5. Private Claims \_\_\_\_\_

1091826  
LIBER 9258 PAGE 14  
12/27/1999 01:15:42 P.M.  
MACOMB COUNTY, MI  
CARMELLA SABAUGH, REG/DEEDS

Register of Deeds Stamp & File Number

I, GEORGE M. PLATZ, in a field survey on JULY 16, 1999, do hereby state that under requirements of P.A. 74, Michigan P.A. of 1970, the corner points mentioned in lines 1 and 2 above were in conformance with regulations and rules therefore as required in the current manual of survey instructions of the United States Department of the Interior, Bureau of Land Management or by a decree of a Court of Law and/or that the corner points mentioned in lines 3, 4 and 5 above were in conformance with the rules of the Michigan Board of Land Surveyors or by a Decree of a Court of Law; established, re-established, monumented, recovered, found as expressed below:

NOTE: Not more than 2 corners, all in the same town and range, may be recorded on this certificate.

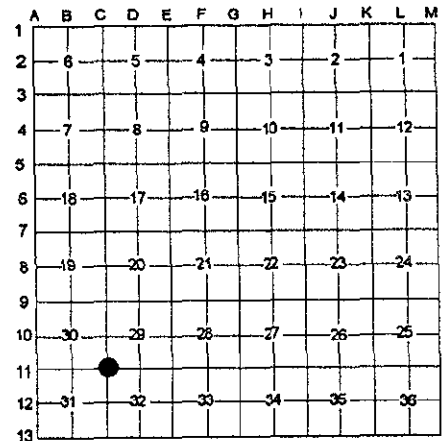

A. Description of original monument and accessories and/or subsequent restoration:

1972	1/2" Pipe	LCRC	R. Smith	#16052	L.2314 P.673
1977	1/2" Rod in box	LCRC	W. Soderberg	#17635	L.2844 P.958
1978	1/2" Rod in box	LCRC	R. Patterson	#17631	L.2940 P.351
1978	1/2" Bar in box	LCRC	H. Avey	#15396	L.3006 P.369
1994	3/4" Rod w/Remonumentation cap in box	LCRC	R. Kohn	#26459	L.6523 P.913
1995	3/4" Rod w/Remonumentation cap in box	LCRC	J. Wright	#40165	L.6832 P.281
1995	3/4" Rod w/Remonumentation cap in box	Survey	J. Wright	#40165	L.6832 P.285

B. Description of corner evidence found and/or method applied in restoring or reestablishing corner:

Found 3/4" rod w/Remonumentation cap #26459 in monument box. Point falls on the ± centerline of Garfield Rd. Asph. Pvmt and ± 1.0' South of the Asphalt Pvmt. centerline of 21 Mile Rd. All previous witnesses are destroyed. Field measurements between adjacent section corners are in substantial agreement with those measured in LCRC L.6523, P.913.

C-11 to B-11	2671.84' (M) 2671.83' (R)	L.6523 P.913	LCRC
C-11 to D-11	2676.67' (M) 2676.66' (R)	L.6523 P.913	LCRC
C-11 to C-12	2664.12' (M) 2664.04' (R)	L.6523 P.913	LCRC


ACCEPTED BY THE MACOMB COUNTY SURVEY PEER GROUP AS THE OFFICIAL CORNER UNDER MICHIGAN PUBLIC ACT 345 OF 1990 AT A MEETING HELD ON 10/26/99  
*William E. Soderberg*  
WILLIAM E. SODERBERG, P.S., CHAIRMAN

C. Description of monument for corner and accessories established to perpetuate locating the position of the corner:

I accepted the found 3/4" rod with 2" diameter aluminum cap found in monument box and stamped "Macomb County Monument MI Act 345 #26459" and re-witnessed point as follows:

Az. 34°	81.35'	Set PK with remonumentation tag in SE Face of U.P.
Az. 138°	64.61'	Set PK with remonumentation tag in NE Face of U.P.
Az. 193°	163.76'	Centerline of top nut on hydrant
Az. 246°	82.24'	Set PK with remonumentation tag in NW Face of U.P.
Az. 288°	115.80'	Centerline of top nut on hydrant

The selected location is accepted by me and generally accepted by Professional Surveyors as the best available evidence of the position of the original corner.

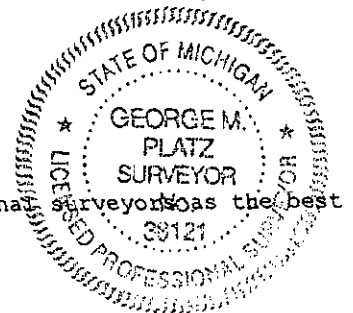

Signed by George M. Platz

Date 10-27-99

Surveyor's Michigan License No. 38121

954