SURVEY &
REMONUMENTATION

APR 2 8 1995

COMMISSION

LAND CORNER RECORDATION CERTIFICATE

Filing Requirement of Act 74, Mich. P.A. 1970

C150772

For corners in Macomb (County)

Macomb Twp.

LIBER 6523 PAGE 919

94 DEC -9 PM 2:48

CARROLL A. SABAUGH
REGISTER OF DEEDS
MACOMB COUNTY, MI

Register of Deeds Stamp & File Number

		Located In:		Corner Code ##
		3N	13E	E-4
1. Public Land Survey		T ____	R ____	____
		T ____	R ____	____
		T ____	R ____	____
		T ____	R ____	____
2. Property Controlling	S ____	T ____	R ____	____
in Section	S ____	T ____	R ____	____
3. Miscellaneous	S ____	T ____	R ____	____
Property in Sec.	S ____	T ____	R ____	____

4. Lot No. ____ , Recorded Plat ____
5. Private Claims ____

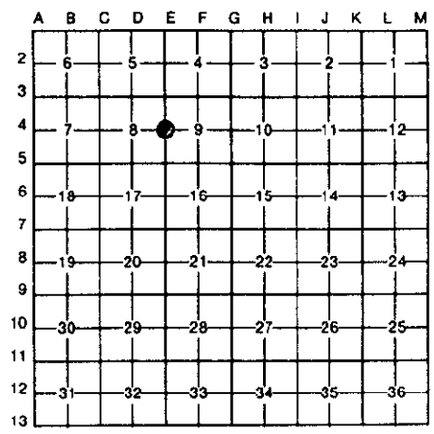

I, Robert D. Kohn, in a field survey on October 13, 19 94, do hereby certify that under requirements of P.A. 74, Michigan P.A. of 1970, the corner points mentioned in lines 1 and 2 above were in conformance with regulations and rules therefore as required in the current manual of survey instructions of the United States Department of the Interior, Bureau of Land Management or by a decree of a Court of Law and/or that the corner points mentioned in lines 3, 4 and 5 above were in conformance with the rules of the Michigan Board of Land Surveyors or by a Decree of a Court of Law; established, re-established, monumented, re-monumented, recovered, found as expressed below:

NOTE: Not more than 4 corners, all in the same town and range, may be recorded on this certificate.

A. Description of original monument and accessories and/or subsequent restoration:

1817	12", Black Ash	Notes	W. Preston	N/A	Notes
1987	1/2" Iron	Survey	D. King	#30085	L4543 P126

B. Description of corner evidence found and/or method applied in restoring or reestablishing corner:
A 1/2" rod at the intersection of wood and wire fences running east-west and south currently marks this corner. No land corner recordation certificate is currently on file at the Register of Deeds Office. Three ties from the survey recorded in L4543 P126 agree with the iron that currently marks this corner.

Field measurements were made between the following corners:

E-3 to E-4	2676.14	meas.		
	2640	rec.	G.L.O.	Notes
E-4 to E-5	2680.58	meas.		
	2680.67	rec.	survey	L4543, P126
	2640	G.L.O.		

ACCEPTED BY THE MACOMB COUNTY SURVEY PEER GROUP AS THE OFFICIAL CORNER UNDER MICHIGAN PUBLIC ACT 345 OF 1990 AT A MEETING HELD ON 10-18-94

William E. Soderberg
WILLIAM E. SODERBERG, P.S., CHAIRMAN

C. Description of monument for corner and accessories established to perpetuate locating the position of the corner:
I replaced the 1/2" iron rod with a 3/4" x 24" iron rod with 2" diameter aluminum cap stamped "Macomb County Monument MI Act 345 #26459".

N.24° E.	20.02'	Set P.K. and remon. tag in N.W. face of 30" Maple
N.74° E.	10.00'	Set P.K. and remon. tag in S. face of 18" Maple
S.52° W.	16.81'	Set P.K. and remon. tag in N.W. face of 36" Oak
N.88° W.	46.51'	Set P.K. and remon. tag in S. face of 30" Ash

STATE OF MICHIGAN
ROBERT D. KOHN
LAND SURVEYOR
NO.
26459
REGISTERED LAND SURVEYOR

The selected location is accepted by me and generally accepted by Professional Surveyors as the best available evidence of the position of the original corner.

Signed by Robert D. Kohn Date November 9, 1994

Surveyor's Michigan License No. 26459

FORM APPROVED BY MICHIGAN STATE BOARD OF LAND SURVEYORS, JAN. 28, 1971
REVISED MAY 14, 1975
REVISED JAN., 1983