

SURVEY & REMONUMENTATION

APR 28 1995

COMMISSION

LAND CORNER RECORDATION CERTIFICATE Filing Requirement of Act 74, Mich. P.A. 1970

C150777

For corners in Macomb

Macomb Twp.

		Located In:		Corner Code #	
(County)		3N	13E	E-10	
1. Public Land Survey		T	R		
		T	R		
		T	R		
		T	R		
2. Property Controlling in Section	S	T	R		
	S	T	R		
3. Miscellaneous Property in Sec.	S	T	R		
	S	T	R		

LIBER 6523 PAGE 924
94 DEC -9 PM 2:48

CARMELLA SABAUGH
REGISTER OF DEEDS
MACOMB COUNTY, MI

Register of Deeds Stamp & File Number

4. Lot No. _____, Recorded Plat _____
5. Private Claims _____

Robert D. Kohn

July 22

94

I, _____, in a field survey on _____, 19____, do hereby certify that under requirements of P.A. 74, Michigan P.A. of 1970, the corner points mentioned in lines 1 and 2 above were in conformance with regulations and rules therefore as required in the current manual of survey instructions of the United States Department of the Interior, Bureau of Land Management or by a decree of a Court of Law and/or that the corner points mentioned in lines 3, 4 and 5 above were in conformance with the rules of the Michigan Board of Land Surveyors or by a Decree of a Court of Law; established, re-established, monumented, re-monumented, recovered, found as expressed below:

NOTE: Not more than 4 corners, all in the same town and range, may be recorded on this certificate.

	A	B	C	D	E	F	G	H	I	J	K	L	M
2	6	5	4	3	2	1							
3													
4	7	8	9	10	11	12							
5													
6	18	17	16	15	14	13							
7													
8	19	20	21	22	23	24							
9													
10	30	29	28	27	26	25							
11													
12	31	32	33	34	35	36							
13													

A. Description of original monument and accessories and/or subsequent restoration:

1817	3" Beech	G.L.O.	W. Preston	N/A	Notes
1969	Set 1" pin	L.C.R.C.	G. Avendt	#16034	L2547 P437
1975	3/4" Iron bar	Survey	H. Kobs	#14097	L2640 P930
1975	3/4" Iron bar	L.C.R.C.	H. Kobs	#14097	L2640 P939
1977	3/4" Steel rod	L.C.R.C.	J. Fenn	#23505	L2844 P956
1979	3/4" Iron	L.C.R.C.	W. Soderberg	#17635	L3197 P100
1979	n/a	Survey	W. Soderberg	#17635	L3197 P108
1985	3/4" Iron bar	L.C.R.C.	D. King	#30085	L4055 P673
1988	3/4" Iron bar				
	in monument box	L.C.R.C.	W. Soderberg	#17635	L4718 P613
1989	3/4" Iron	L.C.R.C.	R. Donnelly	#21583	L4723 P614

B. Description of corner evidence found and/or method applied in restoring or reestablishing corner:

A 1" iron rod in a monument box in asphalt pavement currently marks this corner. The following witness ties were used to recover and verify its position:
3 ties from L.C.R.C. L4723 P614

Field measurements were made between the following corners:


E-10 to E-9	2669.81	meas.			
	2640	rec.	G.L.O.		
	2669.83	rec.	L3197 P108	Survey	
E-10 to E-11	2674.52	meas.			
	2640	G.L.O.			
	2674.55	rec.	L2640 P930	Survey	

ACCEPTED BY THE MACOMB COUNTY SURVEY PEER GROUP AS THE OFFICIAL CORNER UNDER MICHIGAN PUBLIC ACT 345 OF 1990 AT A MEETING HELD ON 9-27-94
William E. Soderberg
WILLIAM E. SODERBERG, P.S., CHAIRMAN

C. Description of monument for corner and accessories established to perpetuate locating the position of the corner:

I replaced the 1" iron rod in asphalt pavement with a 3/4" x 24" iron rod with 2" diameter aluminum stamped "Macomb County Monument MI Act 345 #26459" in an existing monument box.

N.12° E.	162.11'	P.K. Nail and remon. tag W. face U-pole
N.86° W.	63.85'	P.K. Nail and remon. tag N. face 6" Elm
S.28° E.	94.50'	P.K. nail and remon. tag W. face 10" Apple
S.88° E.	32.73'	P.K. nail and remon. tag N. face U-pole

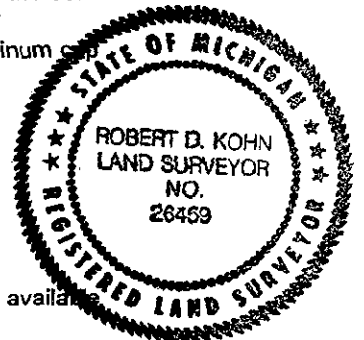

The selected location is accepted by me and generally accepted by Professional Surveyors as the best available evidence of the position of the original corner.

Signed by Robert D. Kohn
Surveyor's Michigan License No. 26459

Date NOVEMBER 9, 1994