


LAND CORNER RECORDATION CERTIFICATE
Filing Requirement of Act 74, Mich. P.A. 1970

For corners in

<u>MACOMB</u> (County)	Located in: Macomb Township	Corner Code #
1. Public Land Survey	T <u>3N</u> R <u>13E</u>	<u>E-13</u>
	T _____ R _____	_____
	T _____ R _____	_____
	T _____ R _____	_____
2. Property Controlling in Section	S _____ T _____	_____
	S _____ T _____	_____
3. Miscellaneous Property in Sec.	S _____ T _____	_____
	S _____ T _____	_____

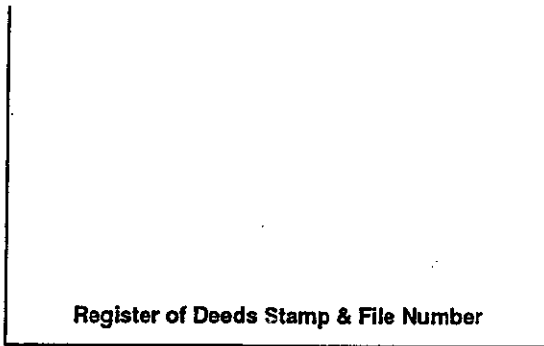

4. Lot No. _____, Recorded Plat _____
 5. Private Claims _____
 ON 12-13-94
William E. Soderberg
 WILLIAM E. SODERBERG, P.S., CHAIRMAN

I, Randy Kolehouse, in a field survey on November 20 19 94, do hereby certify that under requirements of P.A. 74 Michigan P.A. of 1970, the corner points mentioned in lines 1 and 2 above were in conformance with regulations and rules therefore as required in the current manual of survey instructions of the United States Department of the interior, Bureau of Land Management or by a decree of a Court of Law and/or that the corner points mentioned in lines 3, 4 and 5 above were in conformance with the rules of the Michigan Board of Land Surveyors or by a Decree of a Court of Law; established, re-established, monumented, re-monumented, recovered, found as expressed below:

A	B	C	D	E	F	G	H	I	J	K	L	N
2	6	5	4	3	2	1						
3												
4	7	8	9	10	11	12						
5												
6	18	17	16	15	14	13						
7												
8	19	20	21	22	23	24						
9												
10	30	29	28	27	26	25						
11												
12	31	32	33	34	35	36						
13												

NOTE: Not more than 4 corners, all in the same town and range, may be recorded on this certificate.

A. Description of original monument and accessories and/or subsequent restoration:

E-13	1817	G.L.O. Notes	Preston	N/A	Post
	1972	L.C.R.C. & Cert. Survey L. 2302 P. 904 & L. 2295 P. 439	Smith	#16052	Monument Box
	1978	L.C.R.C. L. 2940 P. 350	Patterson	#17631	Iron in Monument Box
	1988	L.C.R.C. L. 4507 P. 853	Schultz	#31610	1/2" Copper Clad Rod w/Cap in Box
	1988	MDOT Notes	N/A	N/A	12" Copper Clad Rod w/Cap in Box
	1989	L.C.R.C. L. 4723 P. 608 Rec. 9-15-89 - Field Work Done on 5-26-87	Donnelly	#21563	C/L Empty Monument Box
	1991	L.C.R.C. L. 5290 P. 292	Avey	#30076	1/2" Bar w/Cap in Mon. Box
	1993	L.C.R.C. L. 6161 P. 248	Antcliff	#25826	Macomb Co. Remon. Marker in Box

B. Description of corner evidence found and/or method applied in restoring or reestablishing corner:

E-13 Previous remonumentation iron and cap was destroyed during M-59 reconstruction. Reset 3/4" rebar in an existing monument box using one witness 1993 remonumentation L.C.R.C. L. 6161 P. 248 and distance from D-13 and F-13.

L.C.R.C. L. 6161 P. 248
 Nail & Tag and PK & Macomb Co. Remon. Tag SW Face P. Pole S 37° E 79.22'


Measures East to F-13 = 2679.37' (WWES 1994 = 2679.40')
 Measures West to D-13 = 2670.86' (WWES 1994 = 2670.76') (MDOT Plans = 2670.63') (MDOT 1988 = 2670.82')
 Measures East to E-1 T2N R13E = 603.86' (WWES 1994 = 604.05')
 Measures West to D-1 T2N R13E = 2073.69' (WWES 1994 = 2073.63')

C. Description of monument for corner and accessories established to perpetuate locating the position of the corner:

E-13 I set a 3/4" x 24" iron rod w/2" diameter aluminum cap stamped "Macomb County Monument MI Act 345 #25854" in an existing monument box.

PK & Macomb Co. Remon. Tag SE Face Util. Pole N 36° E 101.76'
 PK & Macomb Co. Remon. Tag SW Face Util. Pole S 37° E 79.22'
 PK & Macomb Co. Remon. Tag SE Face Util. Pole S 55° W 96.31'
 "+ NE Rim Storm M.H. N 48° W 67.41'

The selected location is accepted by me and is generally accepted by professional surveyors as the best available evidence of the position of the original corner.

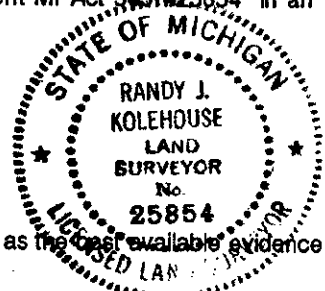

Signed by Randy J. Kolehouse Date 12/16/94
 Surveyor's Michigan License No. 25854