

LAND CORNER RECORDATION CERTIFICATE
Filing Requirement of Act 74, Mich. P.A. 1970

**SURVEY &
 REMONUMENTATION**

For corners in

FEB 27 1997

COMMISSION

Macomb
 (County)

Located In: MacombTwp Corner Code # _____

- | | | | | | |
|------------------------------------|---|-----------|---|------------|-------|
| 1. Public Land Survey | T | <u>3N</u> | R | <u>13E</u> | F-1 |
| | T | _____ | R | _____ | _____ |
| | T | _____ | R | _____ | _____ |
| | T | _____ | R | _____ | _____ |
| 2. Property Controlling in Section | S | _____ | T | _____ | _____ |
| | S | _____ | T | _____ | _____ |
| 3. Miscellaneous Property in Sec. | S | _____ | T | _____ | _____ |
| | S | _____ | T | _____ | _____ |

Register of Deeds Stamp & File Number

4. Lot No. _____, Recorded Plat _____
5. Private Claims _____

	A	B	C	D	E	F	G	H	I	J	K	L	M
1													
2	6			5		4		3		2		1	
3													
4	7			8		9		10		11		12	
5													
6	18			17		16		15		14		13	
7													
8	19			20		21		22		23		24	
9													
10	30			29		28		27		26		25	
11													
12	31			32		33		34		35		36	
13													

I, Robert D. Kohn, in a field survey on November 30, 1996 do hereby state that under requirements of P.A. 74, Michigan P.A. of 1970, the corner points mentioned in lines 1 and 2 above were in conformance with regulations and rules therefore as required in the current manual of survey instructions of the United States Department of the Interior, Bureau of Land Management or by a decree of a Court of Law and for that the corner points mentioned in lines 3, 4 and 5 above were in conformance with the rules of the Michigan Board of Land Surveyors or by a Decree of a Court of Law; established, re-established, monumented, recovered, found as expressed below:

NOTE: Not more than 2 corners, all in the same town and range, may be recorded on this certificate.

A. Description of original monument and accessories and/or subsequent restoration:

1817	No corner set	W. Preston	N/A	GLO Notes
1973	Set iron	F. Bridges	#5779	Survey L2420
1978	R.R. Spike	W. Coulter	#14760	Survey L2932 P832
1993	1/2" iron bar in monument box	D. King	#30085	L.C.R.C. L06613 P522
1993	1/2" iron bar in monument box	D. King	#30085	Surveys L5969 P124, 122 L6595, P746

ACCEPTED BY THE MACOMB COUNTY SURVEY PEI GROUP AS THE OFFICIAL CORNER UNDER MICHIGAN PUBLIC ACT 345 OF 1990 AT A MEETING HE
 ON 7-23-96
William E. Soderberg
 WILLIAM E. SODERBERG, P.S., CHAIRMAN

3. Description of corner evidence found and/or method applied in restoring or reestablishing corner:

A 1/2" iron with cap #30085 in an existing monument box is currently occupying this corner and falls 0.24' north of line from the south 1/4 corner of Section 33 (F-13) and the S.W. corner of Section 33 (E-13). There is evidence of a tree row extending to the south. The following witness ties were used to recover and verify its position:

- 3 ties match witnesses on L.C.R.C. L2932 P832 & L6613 P522
- 3 ties match witnesses on Surveys L5969 P122, 124 & L6595 P746


Field measurements were observed between the following corners:

E-1 to F-1	2687.99 meas.	F-1 to G-1	2687.39 meas.
	2687.93 rec. L5969 P124		2687.23 rec. L6595 P746
	2687.54 rec. L2420 P001		
F-1 to F-13	106.59 meas.		
	106.66 rec. L.C.R.C. L2932 P832		

B. Description of monument for corner and accessories established to perpetuate locating the position of the corner:

replaced the 1/2" iron rod with a 3/4" x 24" iron rod with a 2" diameter aluminum cap stamped "Macomb County Monument MI Act 345 #26459" in an existing monument box in asphalt pavement and corrected its position 0.24' to the south. Witness ties are as follows:

- N. 72°W., 120.70' P.K. nail and Mac. Co. remon. washer in S. face U-pole
- S. 40°E., 83.02' S.W. Cor 1' x 1" conc. bridge rail post
- Due East, 106.59' 1.17" brass cap stamped "Mac Co Act 345" in concrete bridge deck (F-13) Ray Twp.
- N. 45°E., 85.31' N.W. cor 1' x 1" conc. bridge rail post

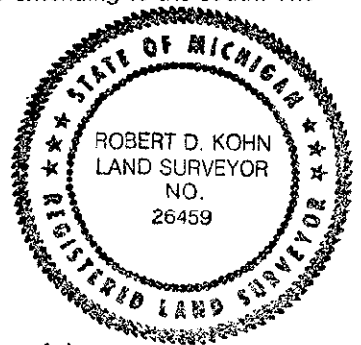

The selected location is accepted by me and generally accepted by Professional Surveyors as the best available evidence of the position of the original corner.

Signed by Robert D. Kohn
 Surveyor's Michigan License No. #26459

Date November 30, 1996

601