SURVEY &
REMONUMENTATION

APR 28 1995

COMMISSION

LAND CORNER RECORDATION CERTIFICATE

Filing Requirement of Act 74, Mich. P.A. 1970

C150781

For corners in Macomb (County)

Macomb Twp.

LIBER 6523 PAGE 928

94 DEC -9 PM 2:49

CARM[illegible] BAUGH
REGISTER OF DEEDS
MACOMB COUNTY, MI

Register of Deeds Stamp & File Number

	Located In:		Corner Code ##
	3N	13E	F-5
1. Public Land Survey	T ____	R ____	_____
	T ____	R ____	_____
	T ____	R ____	_____
	T ____	R ____	_____
2. Property Controlling	S ____ T ____	R ____	_____
in Section	S ____ T ____	R ____	_____
3. Miscellaneous	S ____ T ____	R ____	_____
Property in Sec.	S ____ T ____	R ____	_____

4. Lot No. _____ , Recorded Plat _____
5. Private Claims _____

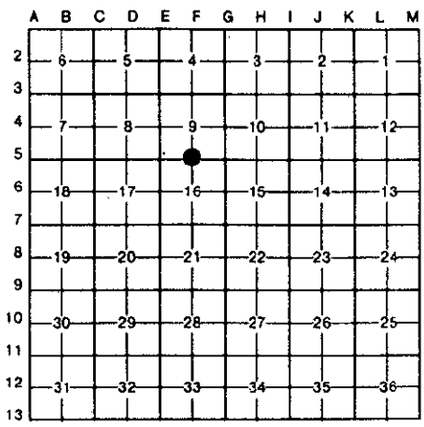

Robert D. Kohn August 8 94

I, _____ , in a field survey on _____ , 19 _____ , do hereby certify that under requirements of P.A. 74, Michigan P.A. of 1970, the corner points mentioned in lines 1 and 2 above were in conformance with regulations and rules therefore as required in the current manual of survey instructions of the United States Department of the Interior, Bureau of Land Management or by a decree of a Court of Law and/or that the corner points mentioned in lines 3, 4 and 5 above were in conformance with the rules of the Michigan Board of Land Surveyors or by a Decree of a Court of Law; established, re-established, monumented, re-monumented, recovered, found as expressed below:

NOTE: Not more than 4 corners, all in the same town and range, may be recorded on this certificate.

A. Description of original monument and accessories and/or subsequent restoration:

1817	Post	G.L.O.	W. Preston	N/A	Notes
1971	1/2" Iron bar	L.C.R.C.	H. Kobs	#14097	L2212 P661
1982	1/2" Iron bar	Survey	H. Kobs	#14097	L3465 P178
1986	1/2" Iron	L.C.R.C.	D. King	#30085	L4077 P535
1989	1/2" Iron	L.C.R.C.	R. Stecker	#30103	L4602 P726
1989	N/A	Survey	R. Stecker	#30103	L4584 P576

B. Description of corner evidence found and/or method applied in restoring or reestablishing corner:

A 1/2" iron rod in a gravel road still marks this corner. The following witness ties were used to recover and verify its position.

1 tie from L.C.R.C. L2212 P661
3 ties from L.C.R.C. L4077 P535
4 ties from L.C.R.C. L4602 P726

Field measurements were made between the following corners:

F-5 to E-5	2675.09	meas.		
	2633.40	G.L.O.		
	2675.02	rec.	L3465 P178	Survey
	2675.43	rec.	L4584 P576	Survey
F-5 to G-5	2673.03	meas.		
	2633.40	G.L.O.		
	2673.23	rec.	L4584 P576	Survey

ACCEPTED BY THE MACOMB COUNTY SURVEY PEER GROUP AS THE OFFICIAL CORNER UNDER MICHIGAN PUBLIC ACT 345 OF 1990 AT A MEETING HELD ON 9-27-94

William E. Soderberg

WILLIAM E. SODERBERG, P.S., CHAIRMAN

C. Description of monument for corner and accessories established to perpetuate locating the position of the corner:

I replaced the 1/2" iron rod with a 3/4" x 24" iron rod in a gravel road with a 2" diameter aluminum disk stamped "Macomb County Monument MI Act 345 #26459".

S.13° E.	92.66'	N.W. corner house #19740
S.71° E.	105.67'	P.K. nail & remon. tag in N. face U-pole
N.77° E.	92.24'	P.K. nail & remon. tag in S. face U-pole
N.50° W.	40.43'	Centerline top nut fire hydrant

STATE OF MICHIGAN
ROBERT D. KOHN
LAND SURVEYOR
NO.
26459
REGISTERED LAND SURVEYOR

The selected location is accepted by me and generally accepted by Professional Surveyors as the best available evidence of the position of the original corner.

Signed by Robert D. Kohn Date November 9, 1994

Surveyor's Michigan License No. 26459

FORM APPROVED BY MICHIGAN STATE BOARD OF LAND SURVEYORS, JAN. 28, 1971
REVISED MAY 14, 1975
REVISED JAN., 1983