

MAR 17 2000

LAND CORNER RECORDATION CERTIFICATE
Filing Requirement of Act 74, Mich. P.A. 1970

For corners in SECTION


Table with columns: MACOMB (County), Located In: MACOMB TWP., Corner Code #: F-13. Rows include Public Land Survey, Property Controlling in Section, and Miscellaneous Property in Sec.

1091828
LIBER 9268 PAGE 16
12/27/1999 01:15:42 P.M.
MACOMB COUNTY, MI
CARNELLA SABAUGH, REG/DEEDS

Register of Deeds Stamp & File Number

4. Lot No. Recorded Plat
5. Private Claims

I, GEORGE M. PLATZ, in a field survey on APRIL 19, 1999, do hereby state that under requirements of P.A. 74, Michigan P.A. of 1970, the corner points mentioned in lines 1 and 2 above were in conformance with regulations and rules therefore as required in the current manual of survey instructions of the United States Department of the Interior, Bureau of Land Management or by a decree of a Court of Law and/or that the corner points mentioned in lines 3, 4 and 5 above were in conformance with the rules of the Michigan Board of Land Surveyors or by a Decree of a Court of Law; established, re-established, monumented, recovered, found as expressed below:

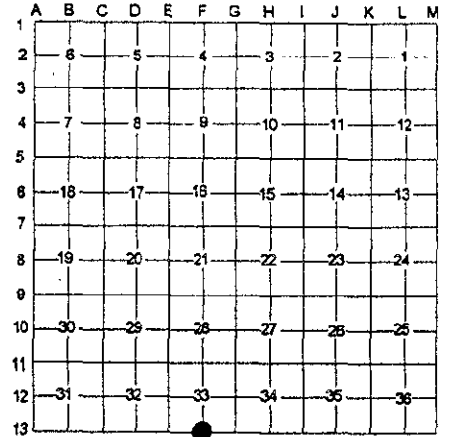

NOTE: Not more than 2 corners, all in the same town and range, may be recorded on this certificate.

A. Description of original monument and accessories and/or subsequent restoration:

Table with columns: Year, Description, Material, Name, ID Number, Notes. Includes entries for Set Post, P.K. Nail, Remon marker w/cap in box, and 1/2" rod in new box.

B. Description of corner evidence found and/or method applied in restoring or reestablishing corner:

Found 1/2" rod in monument box in eastbound lanes of M-59. Except for 1 remaining witness tie from L.C.R.C. L.8394, P.212, all previous witnesses have been destroyed. The one remaining witness, along with field measurement to an adjacent corner, verifies this position.

Remaining witness ties
S44°W 66.79' (M) 66.78' (R)
Field measurements to adjacent corners:
F-13 to E-13 2679.44' (M)
2679.37' (R) L.6161 P.249 LCRC


ACCEPTED BY THE MACOMB COUNTY SURVEY PEER GROUP AS THE OFFICIAL CORNER UNDER MICHIGAN PUBLIC ACT 345 OF 1990 AT A MEETING HELD ON 10/26/99
Signature of William E. Soderberg, P.S., Chairman

C. Description of monument for corner and accessories established to perpetuate locating the position of the corner:

I accepted the found 1/2" rod in monument box. Set 2" diameter aluminum cap stamped "Macomb County Monument MI Act 345 #38121" and re-witnessed point as follows:

- Az. 89° 122.05' Set PK with SDA tag No. 38121 in top of concrete curb
Az. 118° 102.68' Set PK with SDA tag No. 38121 in top of concrete curb
Az. 221° 66.79' Centerline of top nut on hydrant
Az. 287° 50.24' Set PK with SDA tag No. 38121 in top of concrete curb
Az. 313° 38.11' Set PK with SDA tag No. 38121 in top of concrete curb

The selected location is accepted by me and is generally accepted by Professional Surveyors as the best available evidence of the position of the original corner.

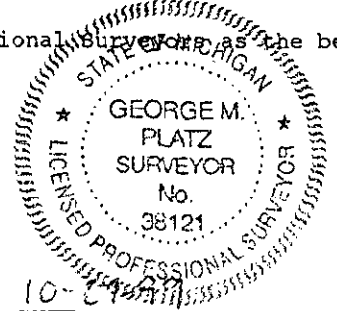

Signed by George M. Platz

Date 10-26-99

Surveyor's Michigan License No. 38121

Handwritten mark 'A 56'