

LAND CORNER RECORDATION CERTIFICATE
Filing Requirement of Act 74, Mich. P.A. 1970

**SURVEY &
REMONUMENTATION**

For corners in

<u>Macomb</u> (County)	Located In: Macomb Twp	Corner Code #
1. Public Land Survey	<u>T 3N R 13E</u>	<u>G-1</u>
	T _____ R _____	_____
	T _____ R _____	_____
	T _____ R _____	_____
2. Property Controlling in Section	S _____ T _____ R _____	_____
	S _____ T _____ R _____	_____
3. Miscellaneous Property in Sec.	S _____ T _____ R _____	_____
	S _____ T _____ R _____	_____

FEB 27 1997

COMMISSION

Register of Deeds Stamp & File Number

4. Lot No. _____, Recorded Plat _____

5. Private Claims _____


I, Robert D. Kohn, in a field survey on November 30, 1996 do hereby state that under requirements of P.A. 74, Michigan P.A. of 1970, the corner points mentioned in lines 1 and 2 above were in conformance with regulations and rules therefore as required in the current manual of survey instructions of the United States Department of the Interior, Bureau of Land Management or by a decree of a Court of Law and /or that the corner points mentioned in lines 3, 4 and 5 above were in conformance with the rules of the Michigan Board of Land Surveyors or by a Decree of a Court of Law; established, re-established, monumented, recovered, found as expressed below:

A	B	C	D	E	F	G	H	I	J	K	L	M
1												
2	6		5		4		3		2		1	
3												
4	7		8		9		10		11		12	
5												
6	18		17		16		15		14		13	
7												
8	19		20		21		22		23		24	
9												
10	30		29		28		27		26		25	
11												
12	31		32		33		34		35		36	
13												

NOTE: Not more than 2 corners, all in the same town and range, may be recorded on this certificate.

A. Description of original monument and accessories and/or subsequent restoration:

1817	4" dia. Black Ash	W. Preston	N/A	G.L.O. Notes
1971	1/2" iron bar	H. Kobs	#14097	Survey L2268, P668-670
1972	1/2" iron bar	H. Kobs	#14097	L.C.R.C. L2268, P703
1993	1/2" iron bar in monument box	D. King	#30085	Survey L6595, P746
1995	1/2" iron bar in monument box	D. King	#30085	L.C.R.C. L6613, P522

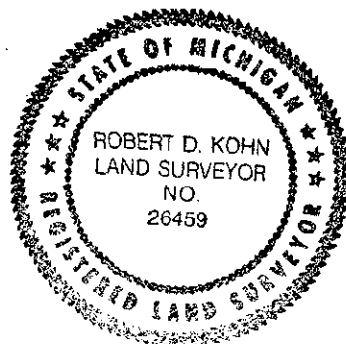

B. Description of corner evidence found and/or method applied in restoring or reestablishing corner:

A 1/2" iron rod in a monument box in asphalt pavement currently occupies this corner and falls on line between the south 1/4 corner of Section 33 (F-13) and the S.E. corner of Section 33 (G-13). The following witness ties were used to recover and verify its position:

- 1 tie matches witnesses on Survey L2268 P668-670 and LCRC L2268 P703
- 2 ties match witnesses on Survey L6595 P746 and L.C.R.C. L6613 P522

ACCEPTED BY THE MACOMB COUNTY SURVEY PEER GROUP AS THE OFFICIAL CORNER UNDER MICHIGAN PUBLIC ACT 345 OF 1990 AT A MEETING HELD ON 7-28-96

William E. Soderberg
WILLIAM E. SODERBERG, P.S., CHAIRMAN

C. Field measurements were observed between the following corners:

- G-1 to F-1 2687.39 meas. G-1 to G-13 89.75 meas.
- 2687.23 rec. survey L6596 P746 87.78 rec. G.L.O.

D. Description of monument for corner and accessories established to perpetuate locating the position of the corner:

replaced the existing 1/2" iron rod with a 3/4" x 24" iron rod with a 2" diameter aluminum cap stamped "Macomb County MI Act 345 #26459" in an existing monument box in asphalt pavement. Witnesses are as follows:

- Due East 89.75' Mac. Co. Remon. cap & iron #26459 in mon. box
- N. 60°W., 128.71' P.K. Nail and Mac. Co. remon. washer in S. Face 36" Maple
- S. 65°E., 54.95' P.K. Nail and Mac. Co. remon. washer in W. Face U-Pole
- S. 20°E., 86.92' P.K. Nail and Mac. Co. remon. washer in W. Face 30" Maple

The selected location is accepted by me and generally accepted by Professional Surveyors as the best available

evidence of the position of the original corner.

Signed by Robert D. Kohn
Surveyor's Michigan License No. #26459

Date November 30, 1996

602