

SURVEY & REMONUMENTATION

APR 28 1995

COMMISSION

C0162130 LIBER:06552 PAGE:427 11:14A 01/13/1995
 CARMELLA SABAUGH-MACOMB COUNTY, MI REG/DEEDS

LAND CORNER RECORDATION CERTIFICATE

Filing Requirement of Act 74, Mich. P.A. 1970

For corners in Macomb

Macomb Twp.

	Located In:		Corner Code #
	3N	13E	
1. Public Land Survey	T _____	R _____	G-4
	T _____	R _____	
	T _____	R _____	
	T _____	R _____	
2. Property Controlling in Section	S _____	T _____ R _____	
	S _____	T _____ R _____	
3. Miscellaneous Property in Sec.	S _____	T _____ R _____	
	S _____	T _____ R _____	

Register of Deeds Stamp & File Number

4. Lot No. _____, Recorded Plat _____
 5. Private Claims _____

Robert D. Kohn

October 14

94

I, _____, in a field survey on _____, 19 _____, do hereby certify that under requirements of P.A. 74, Michigan P.A. of 1970, the corner points mentioned in lines 1 and 2 above were in conformance with regulations and rules therefore as required in the current manual of survey instructions of the United States Department of the Interior, Bureau of Land Management or by a decree of a Court of Law and/or that the corner points mentioned in lines 3, 4 and 5 above were in conformance with the rules of the Michigan Board of Land Surveyors or by a Decree of a Court of Law; established, re-established, monumented, re-monumented, recovered, found as expressed below:

NOTE: Not more than 4 corners, all in the same town and range, may be recorded on this certificate.

	A	B	C	D	E	F	G	H	I	J	K	L	M
2	6	5	4	3	2	1							
3													
4	7	8	9	10	11	12							
5													
6	18	17	16	15	14	13							
7													
8	19	20	21	22	23	24							
9													
10	30	29	28	27	26	25							
11													
12	31	32	33	34	35	36							
13													

A. Description of original monument and accessories and/or subsequent restoration:

1817 Set Post Notes W. Preston N/A Notes
 No land corner recordation certificate has been filed with the Register of Deeds for this corner.

* This recordation certificate is being re-recorded to correct the range number previously recorded in L6523 P932

B. Description of corner evidence found and/or method applied in restoring or reestablishing corner:

A 3/4" iron pipe currently marks this corner. The 3/4" iron is located on an old 4' wood and wire fence line running north-south and 0.5 feet north of an east-west 4' wood and wire fence line.


Field measurements were made between the following corners:

G-3 to G-4	2672.20	meas.	
	2640	G.L.O.	Notes
G-4 to G-5	2688.80	meas.	
	2640	G.L.O.	Notes

ACCEPTED BY THE MACOMB COUNTY SURVEY PEER GROUP AS THE OFFICIAL CORNER UNDER MICHIGAN PUBLIC ACT 345 OF 1990 AT A MEETING HELD ON 10-18-94
William E. Soderberg
 WILLIAM E. SODERBERG, P.S., CHAIRMAN

C. Description of monument for corner and accessories established to perpetuate locating the position of the corner:

I replaced the 3/4" iron rod with a 3/4" x 24" iron rod with 2" diameter aluminum cap stamped "Macomb County Monument MI Act 345 #26459".
 N.47° E. 10.40' Set P.K. and remon. tag in N.W. face 12" Hickory
 S.80° E. 24.25' Set P.K. and remon. tag in S. face of 18" Maple
 S.10° E. 15.70' Set P.K. and remon. tag in W. face of 20" Maple
 N.86° W. 52.83' Set P.K. and remon. tag in S. face of 18" Ash

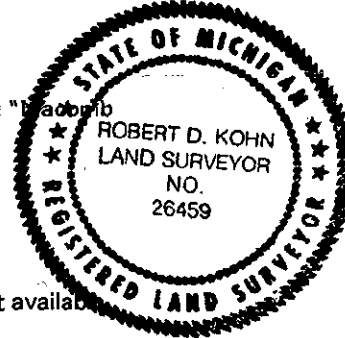

The selected location is accepted by me and generally accepted by Professional Surveyors as the best available evidence of the position of the original corner.

Signed by *Robert D. Kohn* Date JANUARY 12, 1995
 Surveyor's Michigan License No. 26459