SURVEY &
REMONUMENTATION

APR 2 8 1995

COMMISSION

C150786

94 DEC -9 PM 2:49

CARN[illegible]AUGH
REGISTER OF DEEDS
MACOMB COUNTY, MI

LIBER 6523 PAGE 933

Register of Deeds Stamp & File Number

LAND CORNER RECORDATION CERTIFICATE

Filing Requirement of Act 74, Mich. P.A. 1970

For corners in Macomb (County)

Macomb Twp.

	Located In: 3N	13E	Corner Code ## G-5
1. Public Land Survey	T ____	R ____	
	T ____	R ____	
	T ____	R ____	
	T ____	R ____	
2. Property Controlling	S ____ T ____	R ____	
in Section	S ____ T ____	R ____	
3. Miscellaneous	S ____ T ____	R ____	
Property in Sec.	S ____ T ____	R ____	

4. Lot No. _____ , Recorded Plat _____
5. Private Claims _____

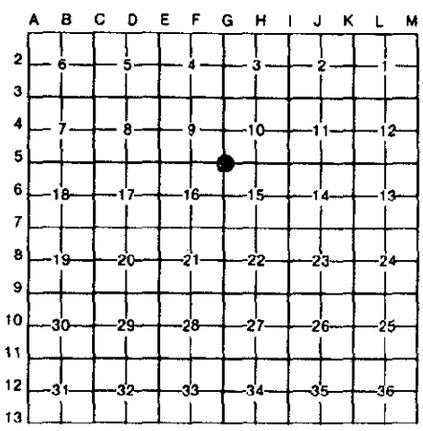

I, Robert D. Kohn, in a field survey on August 8, 19 94, do hereby certify that under requirements of P.A. 74, Michigan P.A. of 1970, the corner points mentioned in lines 1 and 2 above were in conformance with regulations and rules therefore as required in the current manual of survey instructions of the United States Department of the Interior, Bureau of Land Management or by a decree of a Court of Law and/or that the corner points mentioned in lines 3, 4 and 5 above were in conformance with the rules of the Michigan Board of Land Surveyors or by a Decree of a Court of Law; established, re-established, monumented, re-monumented, recovered, found as expressed below:

NOTE: Not more than 4 corners, all in the same town and range, may be recorded on this certificate.

A. Description of original monument and accessories and/or subsequent restoration:

1817	6" Ironwood	G.L.O.	W. Preston	N/A	Notes
No date	3/4" Iron	M.C.R.C.	N/A	N/A	File 59
1975	N/A	Survey	F. Bridges	#5779	L2719 P412
1978	1/2" Pipe	Survey	H. Kobs	#14097	L2923 P850
1978	1/2" Iron	Survey	R. Smith	#16052	L2963 P397
1978	1/2" Iron	L.C.R.C.	R. Smith	#16052	L2963 P417
1980	1/2" Pipe	L.C.R.C.	H. Kobs	#14097	L3252 P338
1989	1/2" Iron	L.C.R.C.	R. Stecker	#30103	L4602 P728
1989	N/A	Survey	R. Stecker	#30103	L4584 P576
1990	1/2" Iron	L.C.R.C.	J. Fenn	#23505	L4810 P939
1991	1/2" Iron bar	L.C.R.C.	D. King	#30085	L5253 P205

B. Description of corner evidence found and/or method applied in restoring or reestablishing corner:

A 1/2" iron rod in a gravel road currently occupies this corner. The following witness ties were used to recover and verify its position.

1 tie from L.C.R.C. L3252 P338
4 ties from L.C.R.C. L4810 P939
3 ties from L.C.R.C. L5253 P205

Field measurements were made between the following corners:

G-5 to F-5	2673.03	meas.		
	2633.40	G.L.O.		
	2673.23	rec.	L4584 P576	Survey
G-5 to H-5	2695.91	meas.		
	2695.80	rec.	L2719 P412	Survey
	2649.90	G.L.O.		
	2695.21	rec.	L2963 P397	Survey
G-5 to G-6	2669.96	meas.		
	2640.00	G.L.O.		
	2669.80	rec.	L2923 P850	Survey
G-5 to G-4	2688.80	meas.		
	2640	G.L.O.		

ACCEPTED BY THE MACOMB COUNTY SURVEY PEER GROUP AS THE OFFICIAL CORNER UNDER MICHIGAN PUBLIC ACT 345 OF 1990 AT A MEETING HELD ON 9-27-94

William E. Soderberg
WILLIAM E. SODERBERG, P.S., CHAIRMAN

C. Description of monument for corner and accessories established to perpetuate locating the position of the corner:

I replaced the 1/2" iron rod with a 3/4" x 24" iron road with 2" diameter aluminum disk stamped "Macomb County Monument MI Act 345 #26459".

N.08° E.	33.76'	Centerline top nut fire hydrant
N.80° E.	135.16'	P.K. nail and remon. tag S. face U-pole
S.47° W.	118.93'	N.W. corner house #20664
Due South	41.70'	P.K. nail and remon tag in W. Face U-pole

STATE OF MICHIGAN
ROBERT D. KOHN
LAND SURVEYOR
NO.
26459
REGISTERED LAND SURVEYOR

The selected location is accepted by me and generally accepted by Professional Surveyors as the best available evidence of the position of the original corner.

Signed by Robert D. Kohn Date November 9, 1994

Surveyor's Michigan License No. 26459

FORM APPROVED BY MICHIGAN STATE BOARD OF LAND SURVEYORS, JAN. 28, 1971
REVISED MAY 14, 1975
REVISED JAN., 1983