SURVEY &
REMONUMENTATION

APR 2 8 1995

COMMISSION

LAND CORNER RECORDATION CERTIFICATE LIBER 6523 PAGE 936

Filing Requirement of Act 74, Mich. P.A. 1970

C150789

94 DEC -9 PM 2:49

CARM[illegible]BAUGH
REGISTER OF DEEDS
MACOMB COUNTY, MI

Register of Deeds Stamp & File Number

For corners in Macomb (County)

Macomb Twp.

	Located In:		Corner Code ##
	3N	13E	G-8
1. Public Land Survey	T ____	R ____	
	T ____	R ____	
	T ____	R ____	
	T ____	R ____	
2. Property Controlling	S ____ T ____	R ____	
in Section	S ____ T ____	R ____	
3. Miscellaneous	S ____ T ____	R ____	
Property in Sec.	S ____ T ____	R ____	

4. Lot No. _____ , Recorded Plat _____
5. Private Claims _____

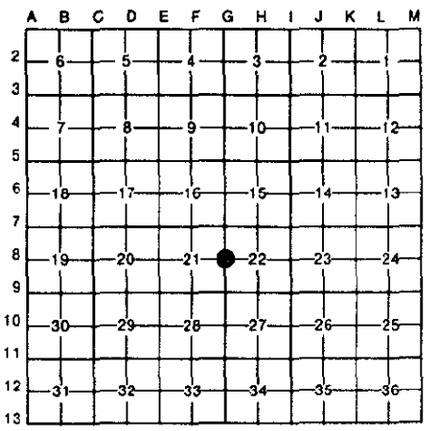

Robert D. Kohn August 31 94

I, _____, in a field survey on _____, 19 _____, do hereby certify that under requirements of P.A. 74, Michigan P.A. of 1970, the corner points mentioned in lines 1 and 2 above were in conformance with regulations and rules therefore as required in the current manual of survey instructions of the United States Department of the Interior, Bureau of Land Management or by a decree of a Court of Law and/or that the corner points mentioned in lines 3, 4 and 5 above were in conformance with the rules of the Michigan Board of Land Surveyors or by a Decree of a Court of Law; established, re-established, monumented, re-monumented, recovered, found as expressed below:

NOTE: Not more than 4 corners, all in the same town and range, may be recorded on this certificate.

A. Description of original monument and accessories and/or subsequent restoration:

1817	Post	G.L.O.	W. Preston	N/A	Notes
1974	1/2" Iron bar	Survey	H. Kobs	#14097	L2534 P432

B. Description of corner evidence found and/or method applied in restoring or reestablishing corner:

A 1/2" re-rod with Surveyors Cap #17635 marks this corner. No L.C.R.C. has ever been recorded for this point.

ACCEPTED BY THE MACOMB COUNTY SURVEY PE
GROUP AS THE OFFICIAL CORNER UNDER MICHIG
PUBLIC ACT 345 OF 1990 AT A MEETING H
ON 10-18-94
William E. Soderberg
WILLIAM E. SODERBERG, P.S., CHAIRMAN

Field measurements were made between the following corners:

G-7 to G-8	2669.41	meas.		
	2640	G.L.O.	Notes	
	2668.58	rec.	N/A	A.E.W. section breakdown
G-8 to G-9	2684.22	meas.		
	2640	G.L.O.	Notes	
	2684.83	rec.	L2534 P432	Survey
	2685.15	rec.	N/A	A.E.W. section breakdown

C. Description of monument for corner and accessories established to perpetuate locating the position of the corner:

I replaced the 1/2" re-rod with a 3/4" x 24" iron rod with 2" diameter aluminum cap stamped "Macomb County Monument MI Act 345 #26459" in an existing monument box.

N.04° E.	8.46′	Set nail and Macomb Co. remon. tag in W. face 6" Ash
S.83° E.	7.78′	Set nail and Macomb Co. remon. tag in N. face 8" Ash
S.07° E.	35.07′	Set nail and Macomb Co. remon. tag in W. face 12" Ash
S.83° W.	30.13′	Set nail and Macomb Co. remon. tag in N. face 12" Ash

STATE OF MICHIGAN
ROBERT D. KOHN
LAND SURVEYOR
NO.
26459
REGISTERED LAND SURVEYOR

The selected location is accepted by me and generally accepted by Professional Surveyors as the best available evidence of the position of the original corner.

Signed by Robert D. Kohn Date November 9, 1994

Surveyor's Michigan License No. 26459

FORM APPROVED BY MICHIGAN STATE BOARD OF LAND SURVEYORS, JAN. 28, 1971
REVISED MAY 14, 1975
REVISED JAN., 1983