

# SURVEY & REMONUMENTATION

APR 28 1995

C150790

## COMMISSION

## LAND CORNER RECORDATION CERTIFICATE Filing Requirement of Act 74, Mich. P.A. 1970

For corners in Macomb  
(County)

Macomb Twp.

Located In: Corner Code #

		3N	13E	G-11
1. Public Land Survey	T	_____	R	_____
	T	_____	R	_____
	T	_____	R	_____
	T	_____	R	_____
2. Property Controlling in Section	S	_____	T	_____
	S	_____	T	_____
3. Miscellaneous Property in Sec.	S	_____	T	_____
	S	_____	T	_____

94 DEC -9 PM 2:49

CARMELO J. NAUGH  
REGISTER OF DEEDS  
MACOMB COUNTY, MI

LIBER 6523 PAGE 937

Register of Deeds Stamp & File Number


4. Lot No. \_\_\_\_\_, Recorded Plat \_\_\_\_\_  
5. Private Claims \_\_\_\_\_

Robert D. Kohn

August 20

94

I, \_\_\_\_\_, in a field survey on \_\_\_\_\_, 19\_\_\_\_\_, do hereby certify that under requirements of P.A. 74, Michigan P.A. of 1970, the corner points mentioned in lines 1 and 2 above were in conformance with regulations and rules therefore as required in the current manual of survey instructions of the United States Department of the Interior, Bureau of Land Management or by a decree of a Court of Law and/or that the corner points mentioned in lines 3, 4 and 5 above were in conformance with the rules of the Michigan Board of Land Surveyors or by a Decree of a Court of Law; established, re-established, monumented, re-monumented, recovered, found as expressed below:

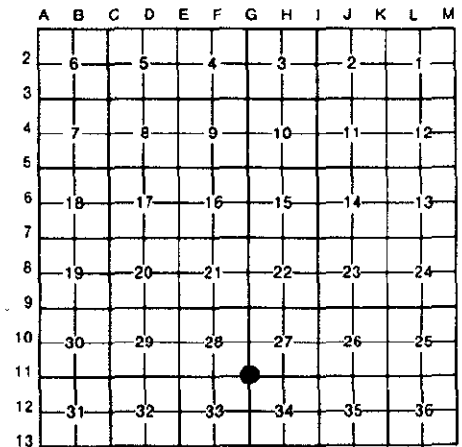

**NOTE: Not more than 4 corners, all in the same town and range, may be recorded on this certificate.**

**A. Description of original monument and accessories and/or subsequent restoration:**

1817 Post	G.L.O.	W. Preston	N/A	Notes
1971 1/2" Pipe	L.C.R.C.	H. Kobs	#14097	L2212 P663
1973 1/2" Bar	L.C.R.C.	H. Avey	#15396	L2522 P271
1974 1/2" Pipe	L.C.R.C.	H. Kobs	#14097	L2548 P980
1986 1/2" Pipe	L.C.R.C.	W. Soderberg	#17635	L4369 P435
1986 1/2" Pipe	Survey	W. Soderberg	#17635	L4369 P418
1987 Iron	Survey	W. Soderberg	#17635	L4421 P853
1989 1/2" pipe	L.C.R.C.	R. Donnelly	#21563	L4723 P611

**B. Description of corner evidence found and/or method applied in restoring or reestablishing corner:**

A 3/4" iron rod in a monument box in asphalt pavement currently marks this corner. The following witness ties were used to recover and verify its position:

1 tie each from L.C.R.C. L2212 P663 and L2548 P980 and L4723 P661

Field measurements were made between the following corners:


G-11 to G-10	2675.33	meas.		
	2640	G.L.O.		
G-11 to H-11	2670.41	meas.		
	2633.4	G.L.O.		
	2670.37	rec.	L4421 P853	Survey
G-11 to G-12	2670.94	meas.		
	2640	rec.	G.L.O.	
	2670.88	rec.	L97 P1-5	Plats
G-11 to F-11	2678.45	meas.		
	2643.3	G.L.O.		
	2678.44	rec.	L4369 P418	Survey

ACCEPTED BY THE MACOMB COUNTY SURVEY PEER  
GROUP AS THE OFFICIAL CORNER UNDER MICHIGAN  
PUBLIC ACT 345 OF 1990 AT A MEETING HELD  
ON 9-27-94  
William E. Soderberg  
WILLIAM E. SODERBERG, P.S., CHAIRMAN

**C. Description of monument for corner and accessories established to perpetuate locating the position of the corner:**

I replaced the 3/4" iron rod with a 3/4" x 24" iron rod with 2" diameter aluminum cap stamped "Macomb County Monument MI Act 345 #26459" in an existing monument box.

N.58° W.	56.29'	P.K. nail and remon. tag in U-pole
N.63° E.	69.12'	Centerline top nut fire hydrant
S.55° W.	58.06'	P.K. nail and remon. tag N. face U-pole
S.72° E.	100.17'	P.K. nail and remon. tag W. face U-pole

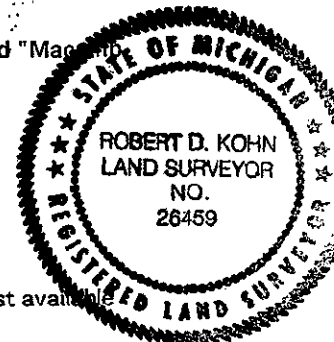

The selected location is accepted by me and generally accepted by Professional Surveyors as the best available evidence of the position of the original corner.

Signed by Robert D. Kohn

Date NOVEMBER 9, 1994

Surveyor's Michigan License No. 26459