

LAND CORNER RECORDATION CERTIFICATE
Filing Requirement of Act 74, Mich. P.A. 1970

For corners in

Macomb Located In: Macomb Twp. Corner Code # _____
 (County)


1. Public Land Survey T-3-N R-13-E H-3
 T _____ R _____
 T _____ R _____
 T _____ R _____

2. Property Controlling in Section S _____ T _____ R _____
S _____ T _____ R _____

3. Miscellaneous Property in Sec. S _____ T _____ R _____
S _____ T _____ R _____

4. Lot No. _____, Recorded Plat _____

5. Private Claims _____

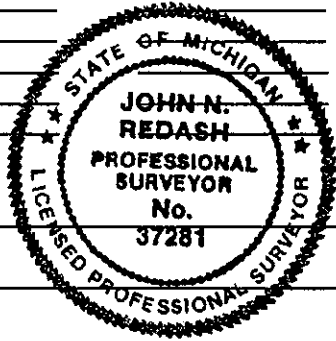

SURVEY &
 REMONUMENTATION

MAR 15 1999

SECTION

Register of Deeds Stamp & File Number

I, John N. Redash, in a field survey on Jan. 6, 1998 do hereby state that under requirements of P.A. 74, Michigan P.A. of 1970, the corner points mentioned in lines 1 and 2 above were in conformance with regulations and rules therefore as required in the current manual of survey instructions of the United States Department of the Interior, Bureau of Land Management or by a decree of a Court of Law and for that the corner points mentioned in lines 3, 4 and 5 above were in conformance with the rules of the Michigan Board of Land Surveyors or by a Decree of a Court of Law; established, re-established, monumented, recovered, found as expressed below:

NOTE: Not more than 2 corners, all in the same town and range, may be recorded on this certificate.

	A	B	C	D	E	F	G	H	I	J	K	L	M
1													
2		6		5		4		3		2			1
3								●					
4		7		8		9		10		11			12
5													
6		18		17		16		15		14			13
7													
8		19		20		21		22		23			24
9													
10		30		29		28		27		26			25
11													
12		31		32		33		34		35			36
13													

A. Description of original monument and accessories and/or subsequent restoration:

Date	Description	G.L.O. Notes	W. Preston	N/A	N/A
1817	5" Dia. Beech		W. Preston		
1973	7/8" Hex. bar in hand hole	L.C.R.C.	H. Avey	#15398	L2426, P333
1973	3/4" Rod in mon. box	L.C.R.C.	R. Smith	#16052	L2445, P720
1973	3/4" Rod in mon. box	Survey	R. Smith	#16052	L2445, P719
1975	7/8" Hex. bar in mon. box	Survey	C. Melching	#14767	L2643, P400
1979	Found 3/4" bar in mon. box	Survey	K. Thompson	#16054	L3133, P371
1980	Found 3/4" bar in mon. box	Survey	K. Thompson	#16054	L3245, P394
1981	Monument box	Survey	K. Thompson	#16054	L3331, P415
1993	Hex. bar in mon. box	L.C.R.C.	R. Stecker	#30103	L5767, P679
1994	Hex. bar in mon. box	L.C.R.C.	R. Stecker	#30103	L6483, P110
1995	Hex. bar in mon. box	L.C.R.C.	J. Wright	#40165	L6832, P273

B. Description of corner evidence found and/or method applied in restoring or reestablishing corner:

A 3/4" Hex. iron in an existing monument box in asphalt pavement at the intersection of 25 Mile Road and Foss Road currently occupies this corner. The following witness ties were used to recover and verify its position: 1 tie matches current measurements from L.C.R.C. L2426, P333, and L2445, P720; while 4 ties match L.C.R.C.s L5767, P679, L6483, P110, and L6832, P273. Field measurements were observed between the following corners:

G-3 to H-3	H-3 to I-3
2656.50 G.L.O.	2656.50 G.L.O.
2693.49 Meas.	2693.89 Meas.
2693.48 Rec. of tax descriptions	

ACCEPTED BY THE MACOMB COUNTY SURVEY PEER GROUP AS THE OFFICIAL CORNER UNDER MICHIGAN PUBLIC ACT 345 OF 1990 AT A MEETING HELD ON 10/13/98
William E. Soderberg
 WILLIAM E. SODERBERG, P.S., CHAIRMAN

C. Description of monument for corner and accessories established to perpetuate locating the position of the corner:

I set a 2" aluminum cap stamped "Macomb County Monument MI Act 345 #37281" on the existing 3/4" hex iron in an existing monument box. Witnesses are as follows:

AZ.	357°	62.46'	Set mag. nail and Macomb County Remon. tag E. face u-pole
AZ.	135°	49.15'	Set mag. nail and Macomb County Remon. tag in S.W. face if 6" Elm
AZ.	216°	57.22'	Set punch hole centerline top of nut fire hydrant
AZ.	315°	66.39'	Found P.K. nail with tag #30103 in Tag N.E. face 36" Cedar
AZ.	356°	34.54'	Set mag. nail and Macomb County Remon. Tag E. face 21" Walnut

The selected location is accepted by me and generally accepted by Professional Surveyors as the best available evidence of the position of the original corner.

Signed by *John N. Redash* Date 12-23-98
 Surveyor's Michigan License No. 37281

822